


TOWN OF LEXINGTON — BOARD OF PUBLIC WORKS

WATER DIVISION

Sketch of Service Here

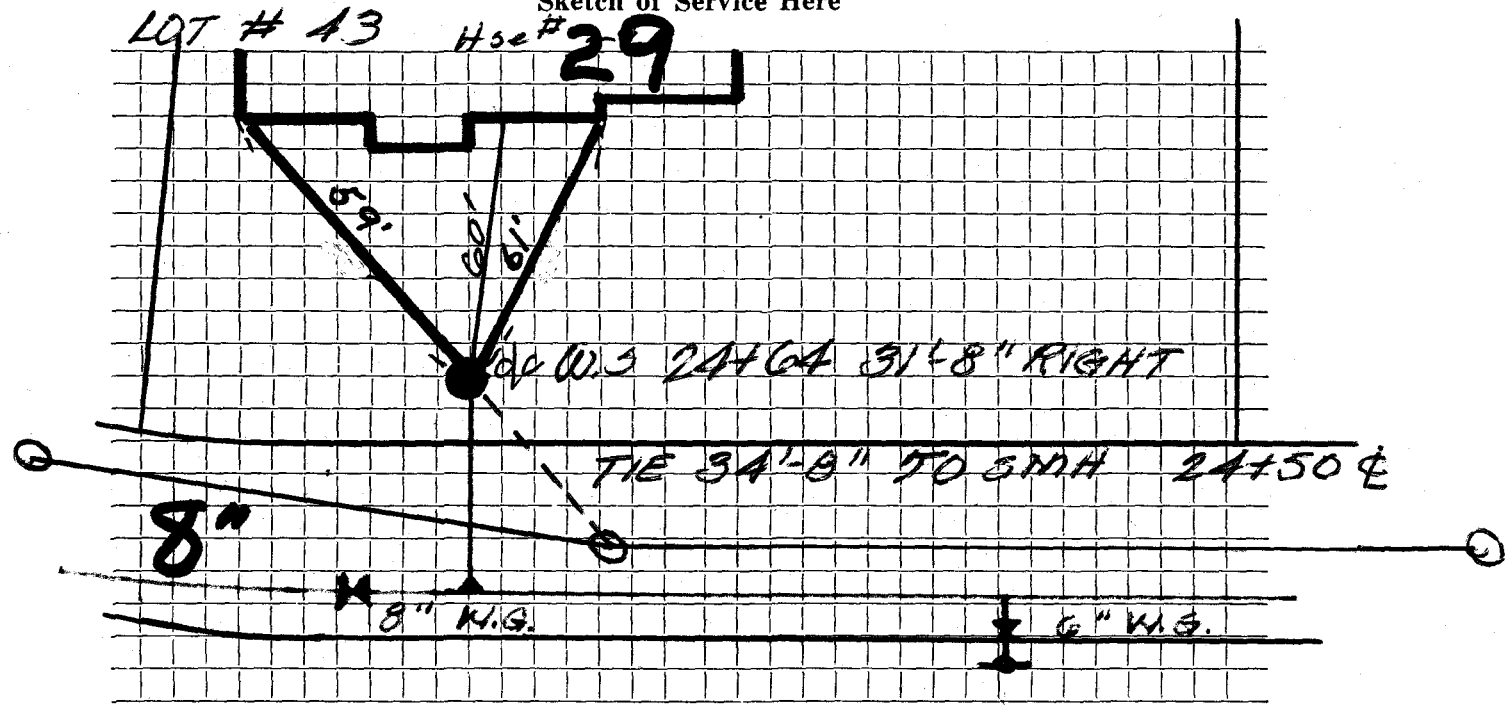

Connection made in WILSON PIERCE Street. Work completed

Remarks: 8" GATE VALVE
6" GATE VALVE
HYDRANT