


DATE 6/26/90
G.T.S.

TOWN OF LEXINGTON — BOARD OF PUBLIC WORKS

WATER DIVISION

Sketch of Service Here

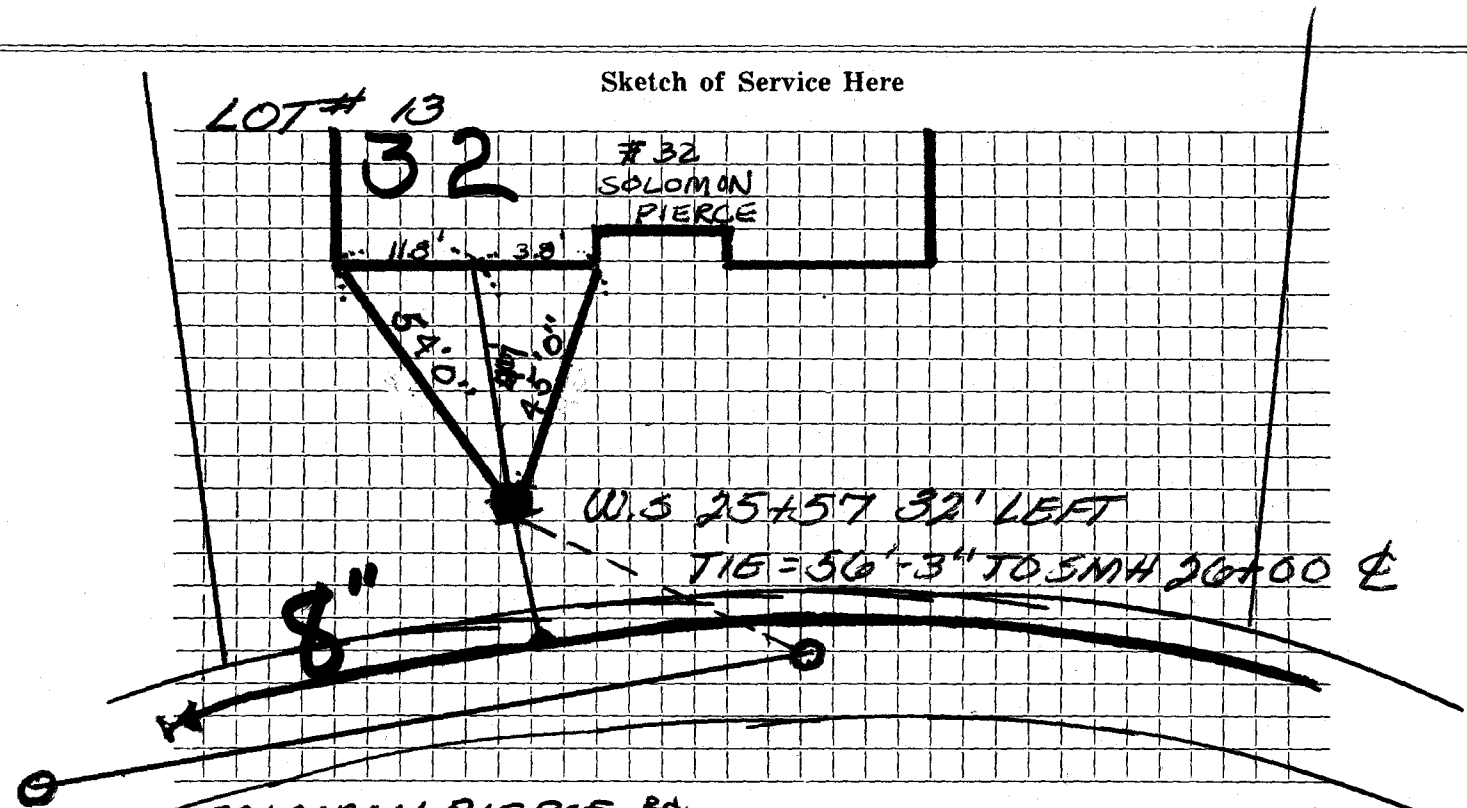

Connection made in SOLOMON PIERCE Rd. ~~Street~~

Work completed

Remarks: ...INSPECTED: G.T. SAMAHA.....

CONTRACTOR: J. MCLAUGHLIN.....