




DATE 7/90

TOWN OF LEXINGTON — BOARD OF PUBLIC WORKS

P.A.B.

WATER DIVISION

Sketch of Service Here

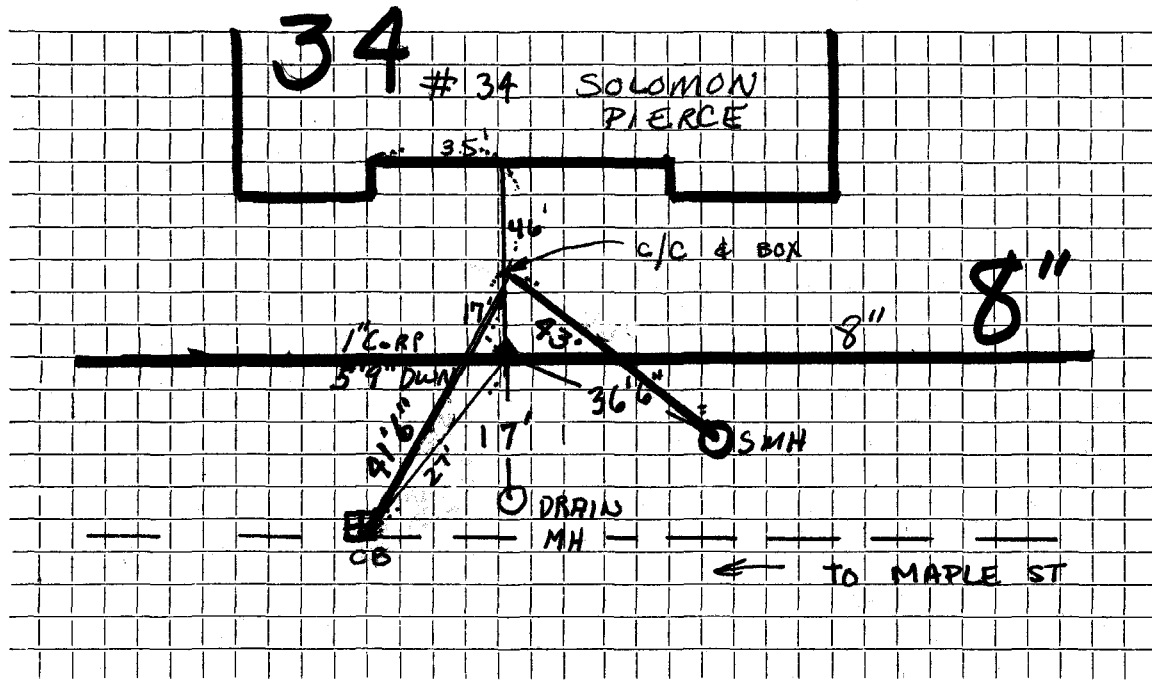

Connection made in ... SOLOMON PIERCE ... Rd: Street: Work completed .....

Remarks: INSPECTED: P. A. BARROWS .....

CONTRACTOR: J. MCLAUGHLIN .....