




DATE \_\_\_\_\_

TOWN OF LEXINGTON — BOARD OF PUBLIC WORKS

WATER DIVISION

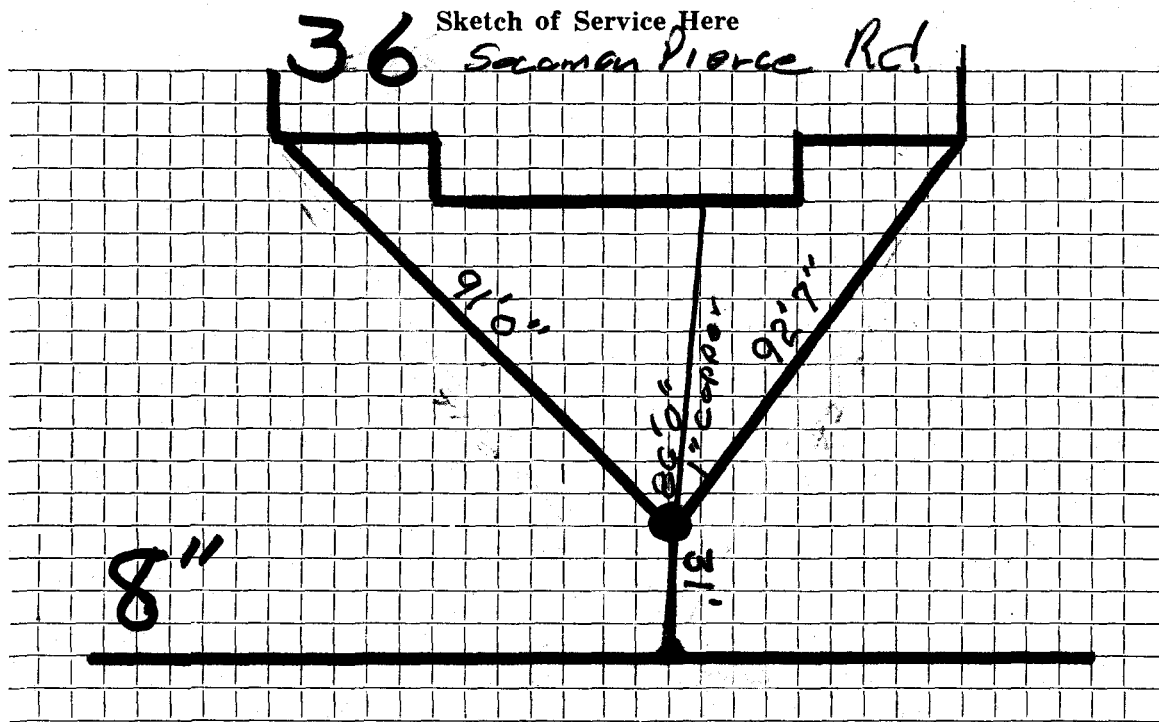

Connection made in Salamon Pierce Rd Street. Work completed 1986

Remarks: .....

.....

.....