

**WATER SERVICE RECORD**

**Name**

**Service No.**

**Address**

#38 Solomon Pierce Rd.

**Location**

**Repair—Renewal—(New Service)**

Date	Material	Amount	Total	Date	Amount
4/15/86	56'0" of 1" Copper				


4/15/86

56'0" of 1" Copper

DATE \_\_\_\_\_

TOWN OF LEXINGTON — BOARD OF PUBLIC WORKS

WATER DIVISION

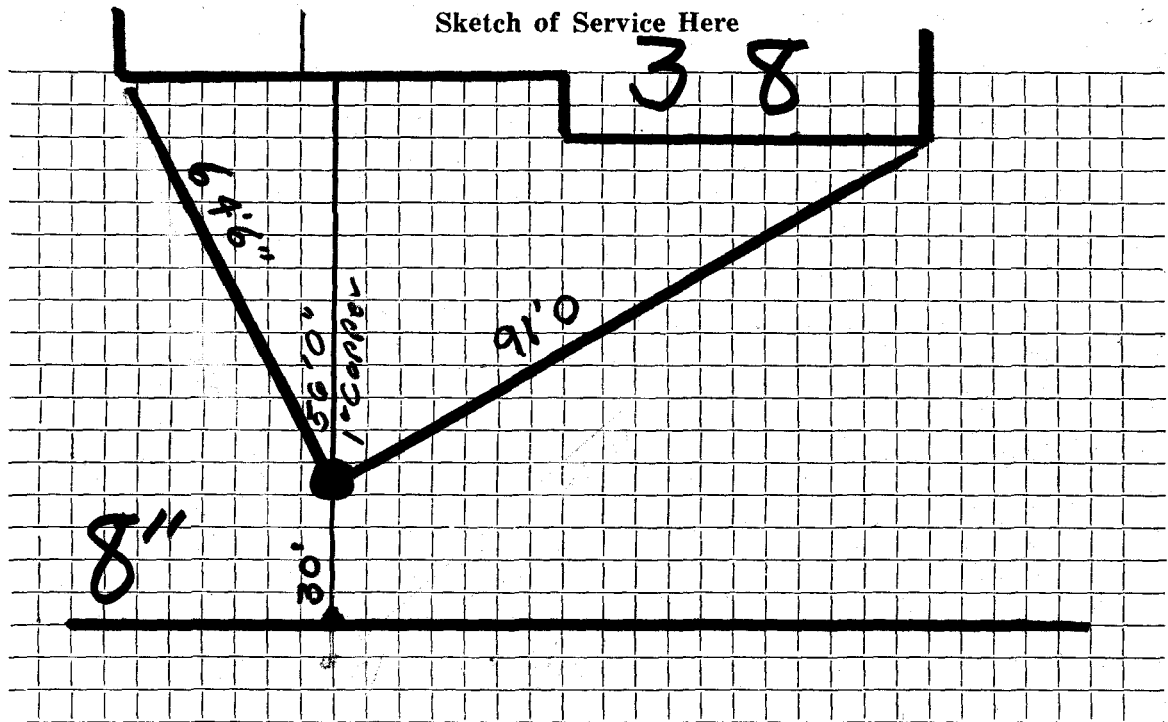

Connection made in *Salem Pierce Rd.* ~~Street~~

Work completed *4/15/60*

Remarks: .....

.....

.....