


TOWN OF LEXINGTON — BOARD OF PUBLIC WORKS
WATER DIVISION

Sketch of Service Here

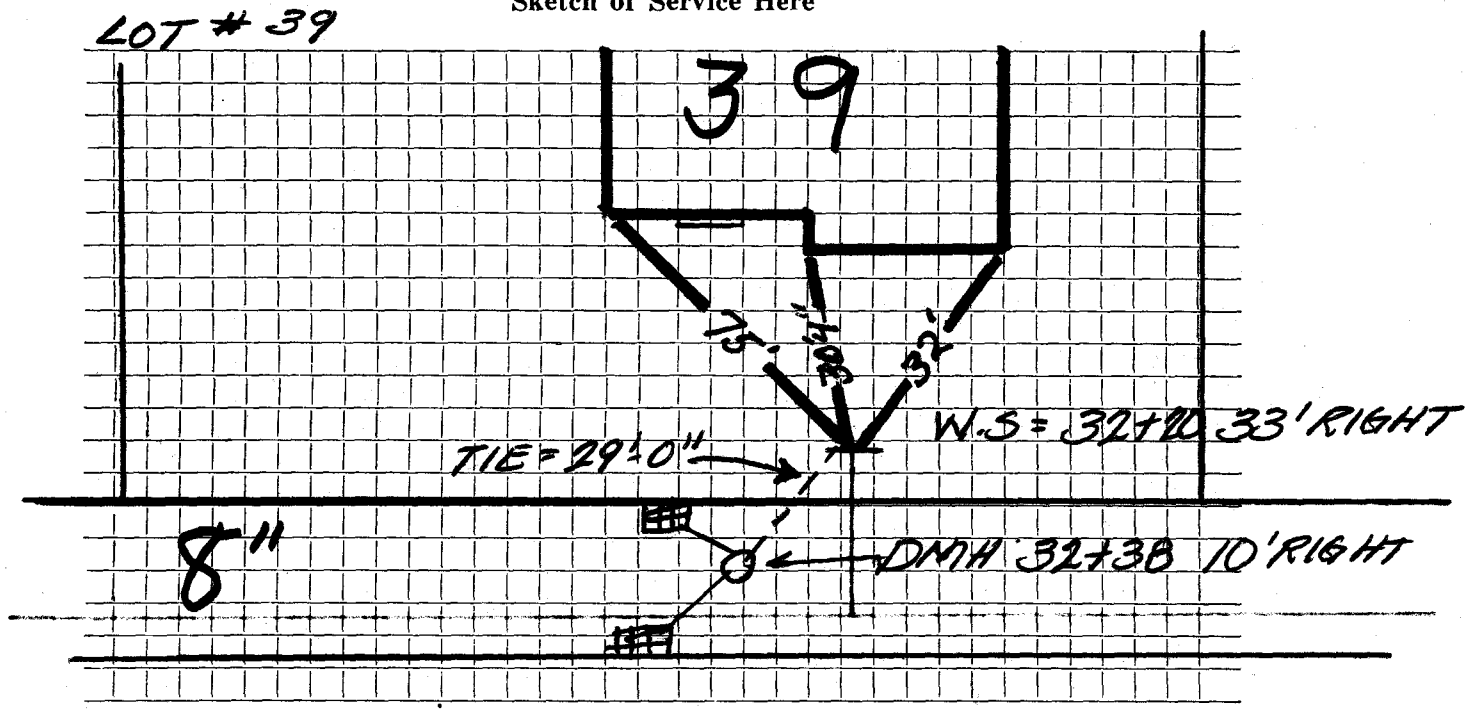

Connection made in SOLOMON PIERCE Street.

Work completed

Remarks:

.....

.....