

DATE _____


TOWN OF LEXINGTON — BOARD OF PUBLIC WORKS

WATER DIVISION

LOT # 21A

N/F KIRKSEY

Sketch of Service Here

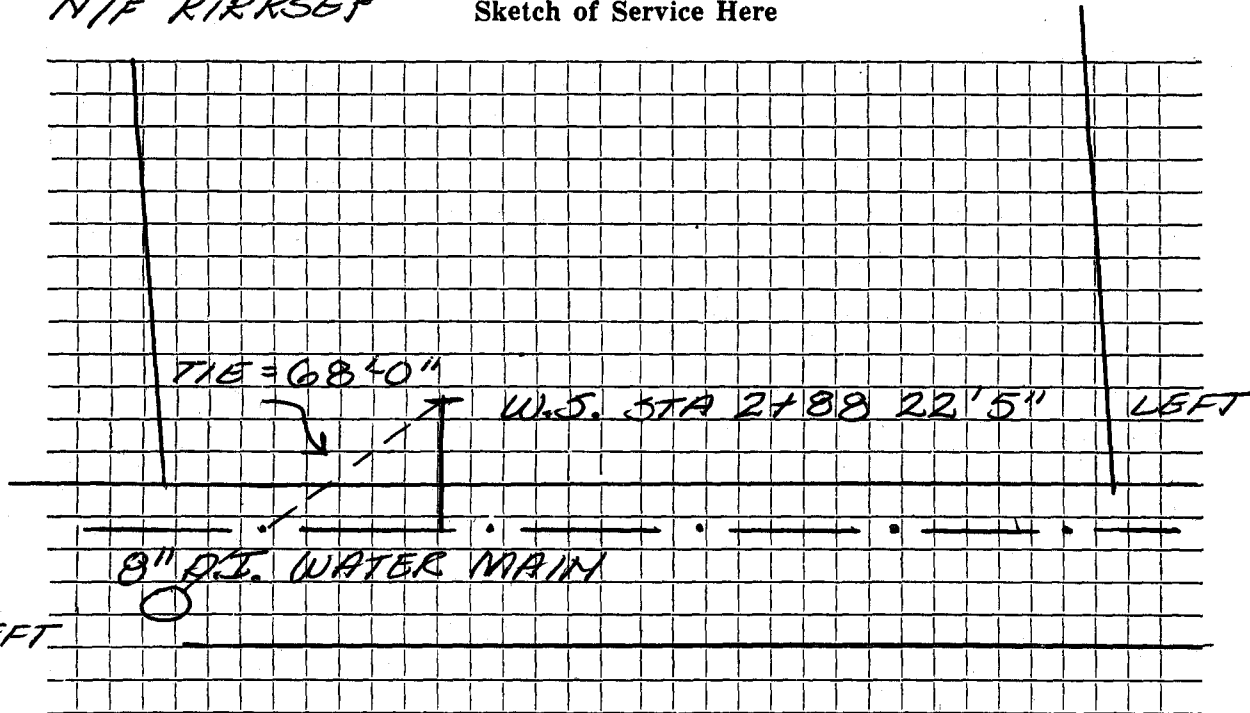

S.M.H
2+23 2' LEFT

Connection made in SOLOMON PIERCE Street.


Work completed

Remarks:
.....
.....

DATE _____

TOWN OF LEXINGTON — BOARD OF PUBLIC WORKS
WATER DIVISION

Sketch of Service Here

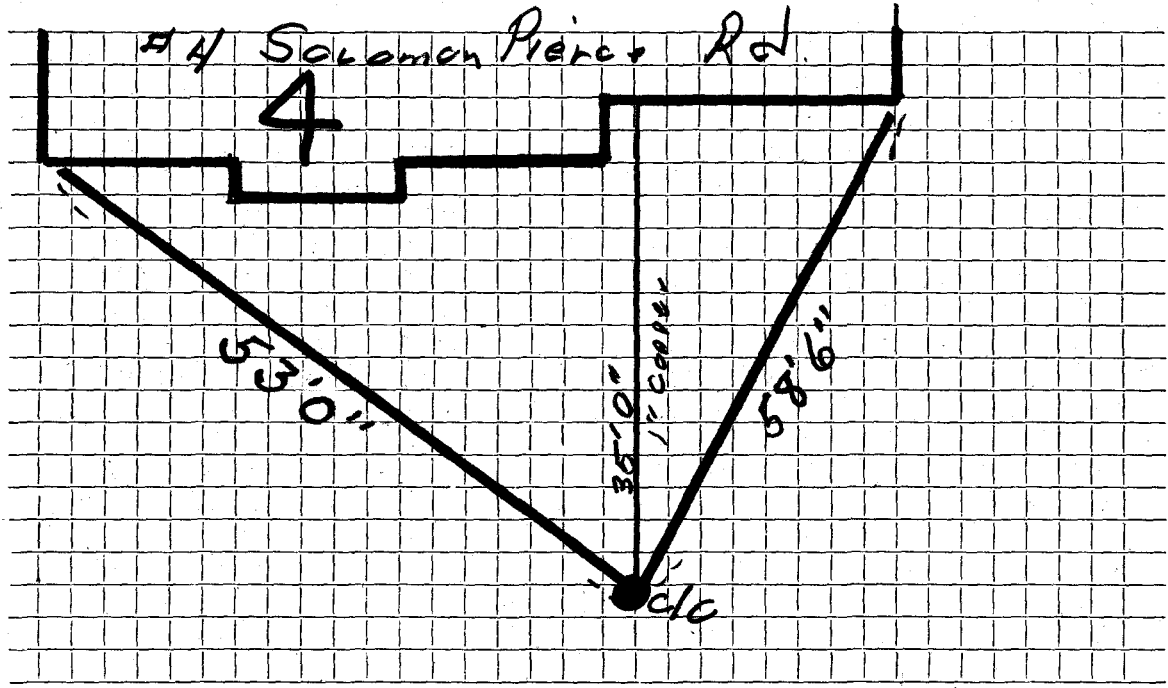

Connection made in Sakamon P. B.C. Rd. ~~Street~~

Work completed 1966

Remarks:

.....

.....