




TOWN OF LEXINGTON — BOARD OF PUBLIC WORKS

WATER DIVISION

Sketch of Service Here

LOT # 7

44

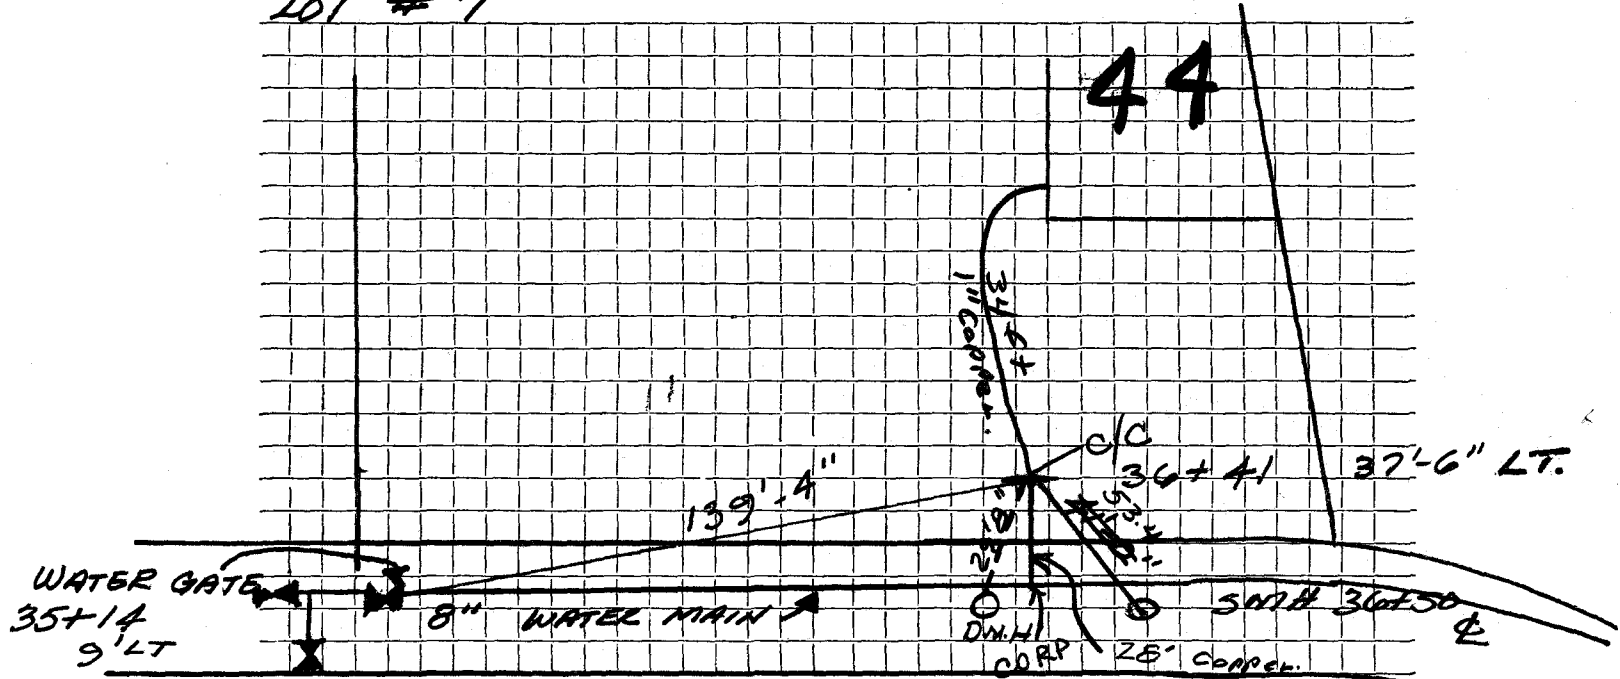

Connection made in SOLOMON PIERCE Street. Work completed .....

Remarks: WATER TAP = STATION 30+41 10' LT. .....