


DATE _____

TOWN OF LEXINGTON — BOARD OF PUBLIC WORKS

WATER DIVISION

Sketch of Service Here

LOT 59

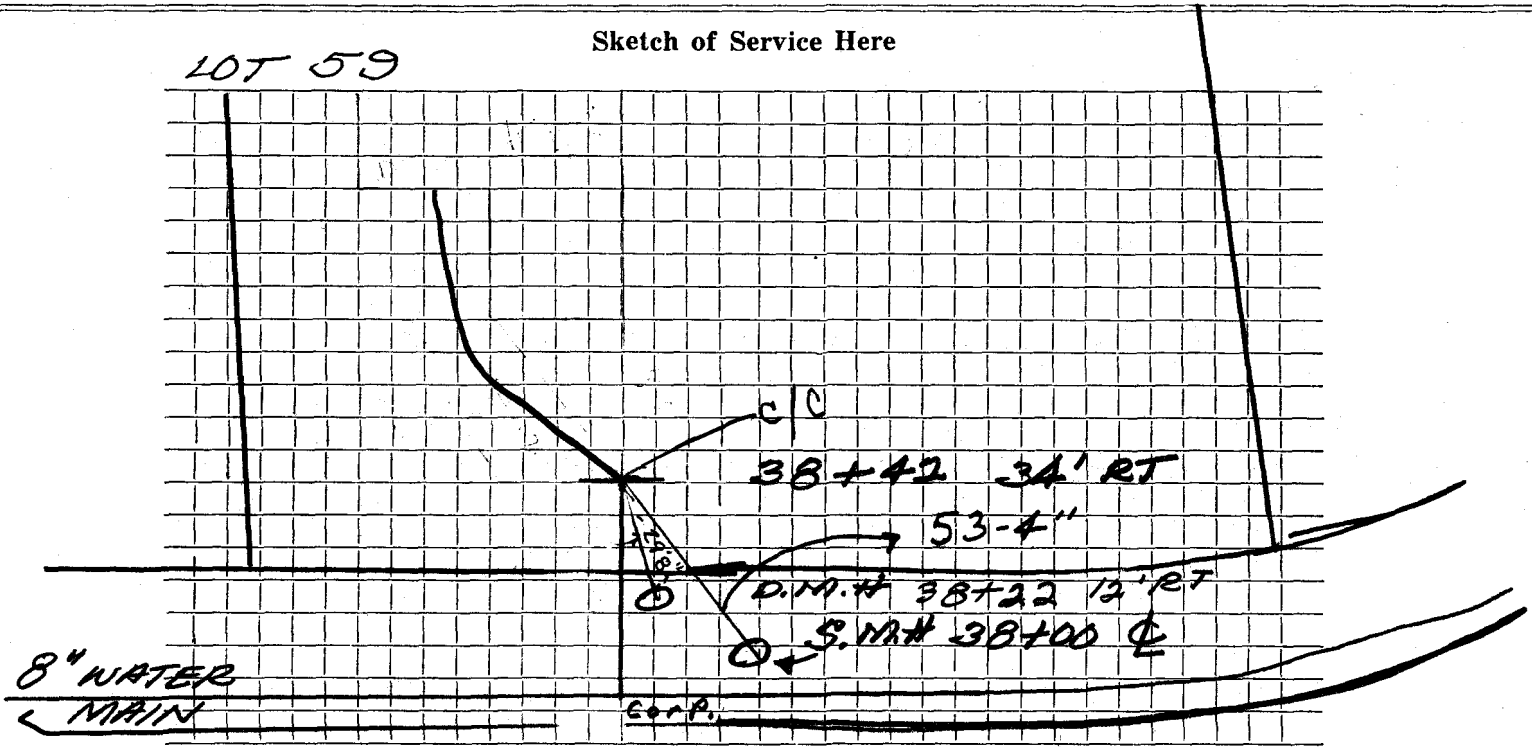

Connection made in SOLOMON PIERCE Street. Work completed

Remarks: WATER TAP = STATION 38+42 8' LT

.....
.....