


DATE _____

TOWN OF LEXINGTON — BOARD OF PUBLIC WORKS
WATER DIVISION

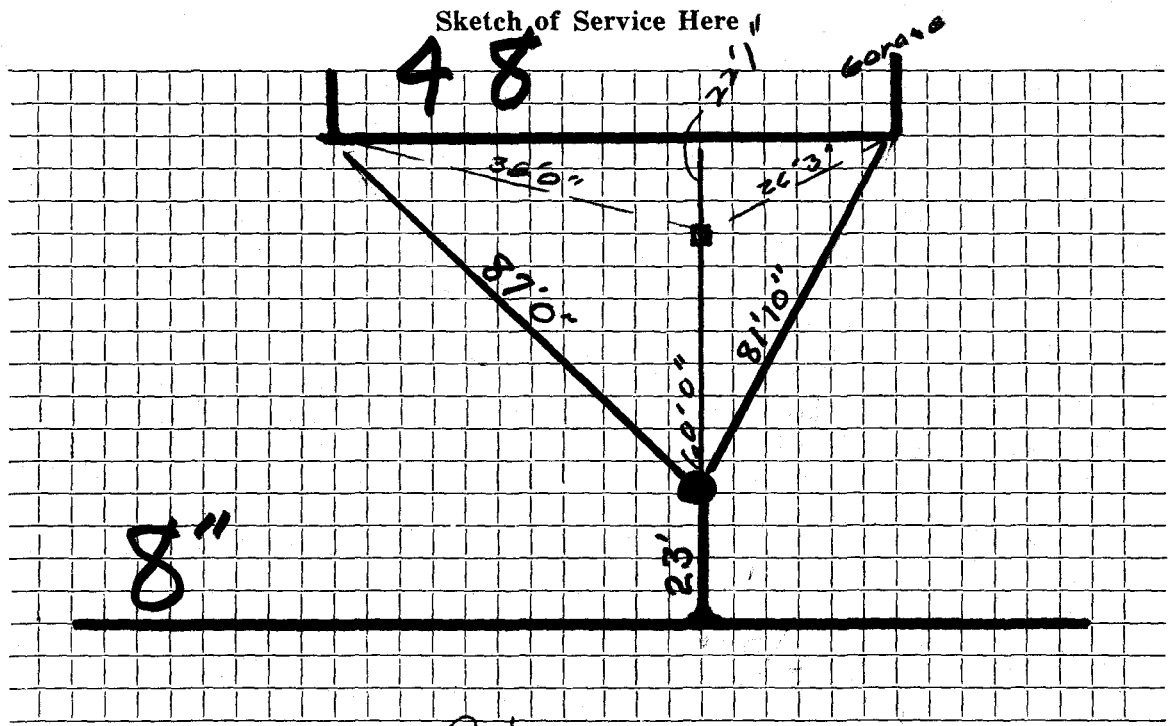

Connection made in Salemman Pierce Street RD Work completed 5/16/EC

Remarks:

.....

.....