

DATE _____

TOWN OF LEXINGTON — BOARD OF PUBLIC WORKS

WATER DIVISION


Sketch of Service Here

LOT # 61

49

#49

1" copper

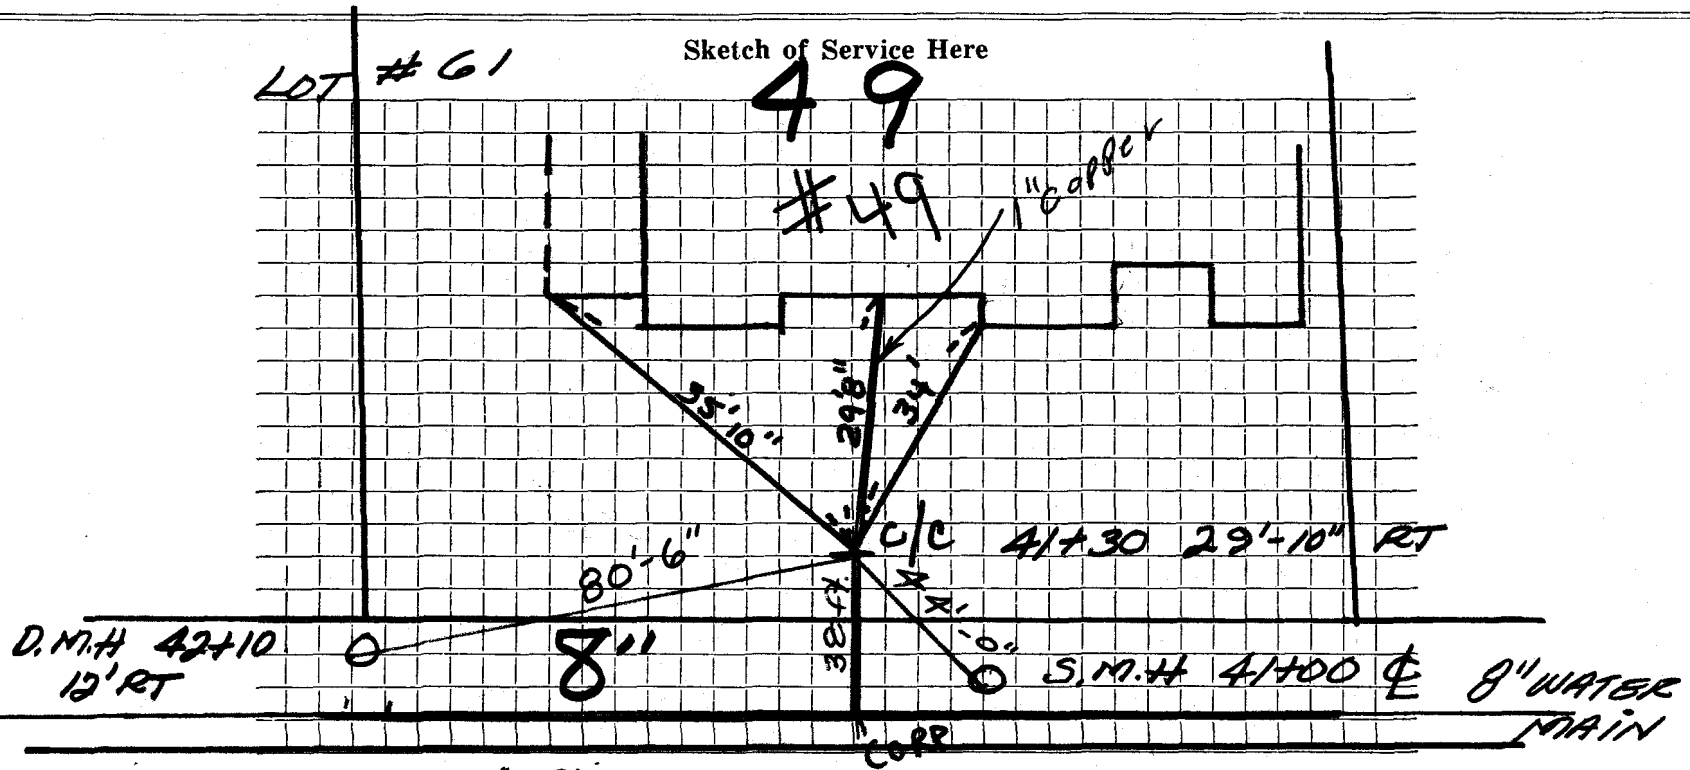

Connection made in SOLONON PIERCE Street. Work completed

Remarks: WATER TAP = STATION = 41+30 8' LT