


TOWN OF LEXINGTON — BOARD OF PUBLIC WORKS

WATER DIVISION

Sketch of Service Here

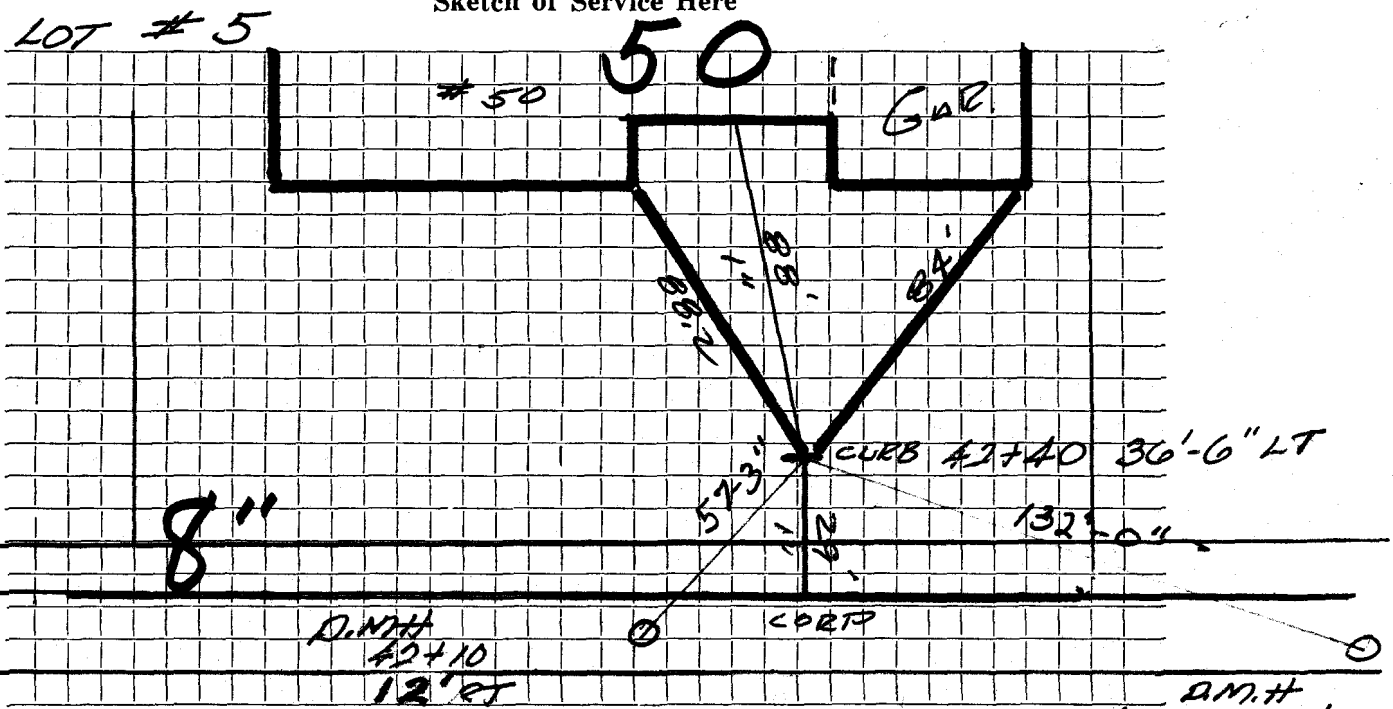

Connection made in SOLOMON PIERCE Street. Work completed

Remarks: WATER TAP = STATION 42+40 : 8' LT