


DATE _____

TOWN OF LEXINGTON — BOARD OF PUBLIC WORKS

WATER DIVISION

Sketch of Service Here

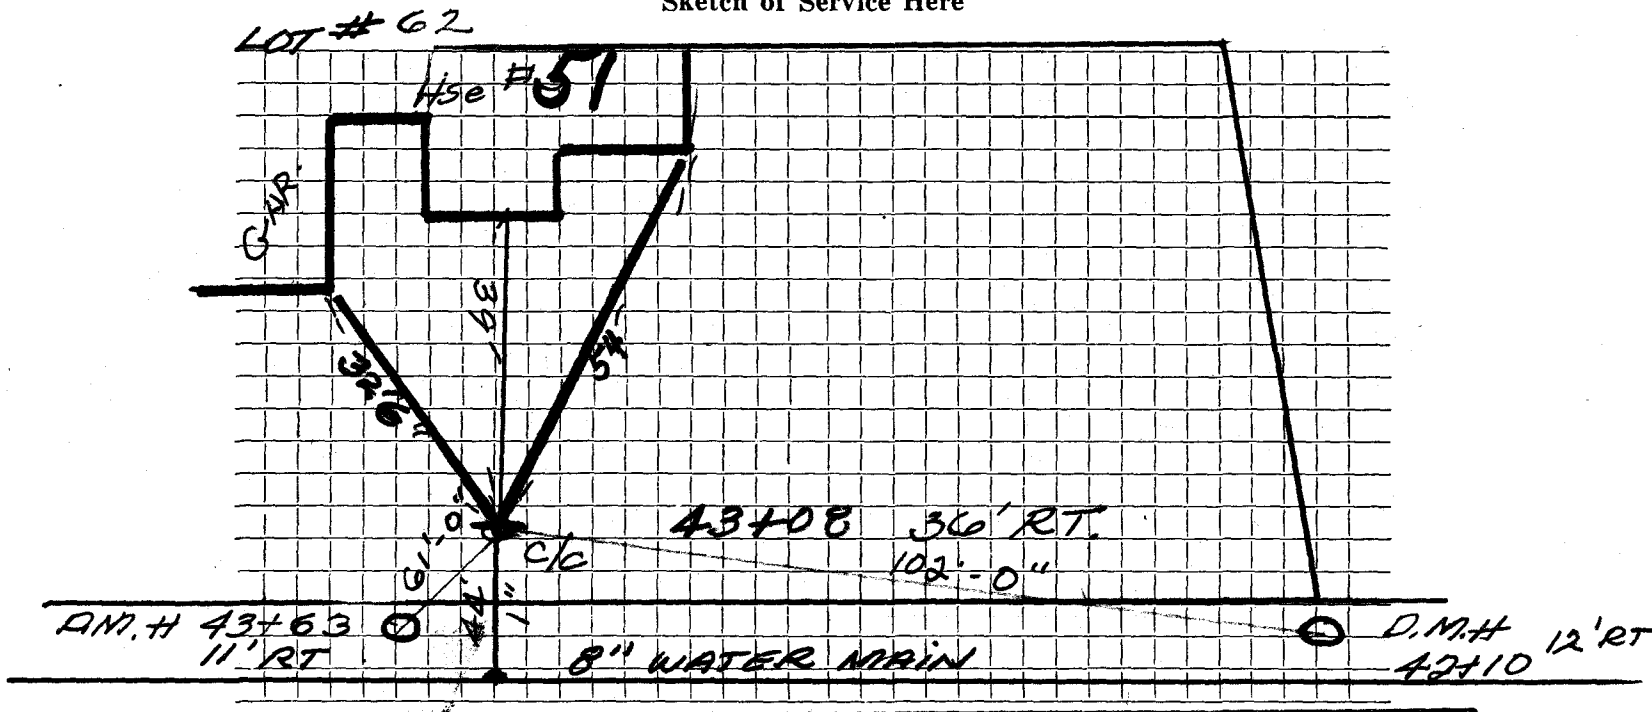

Connection made in SOLAMON PIERCE Street. Work completed

Remarks: .. WATER TAP = 43+08 8' LT.