




TOWN OF LEXINGTON — BOARD OF PUBLIC WORKS

WATER DIVISION

52

Sketch of Service Here

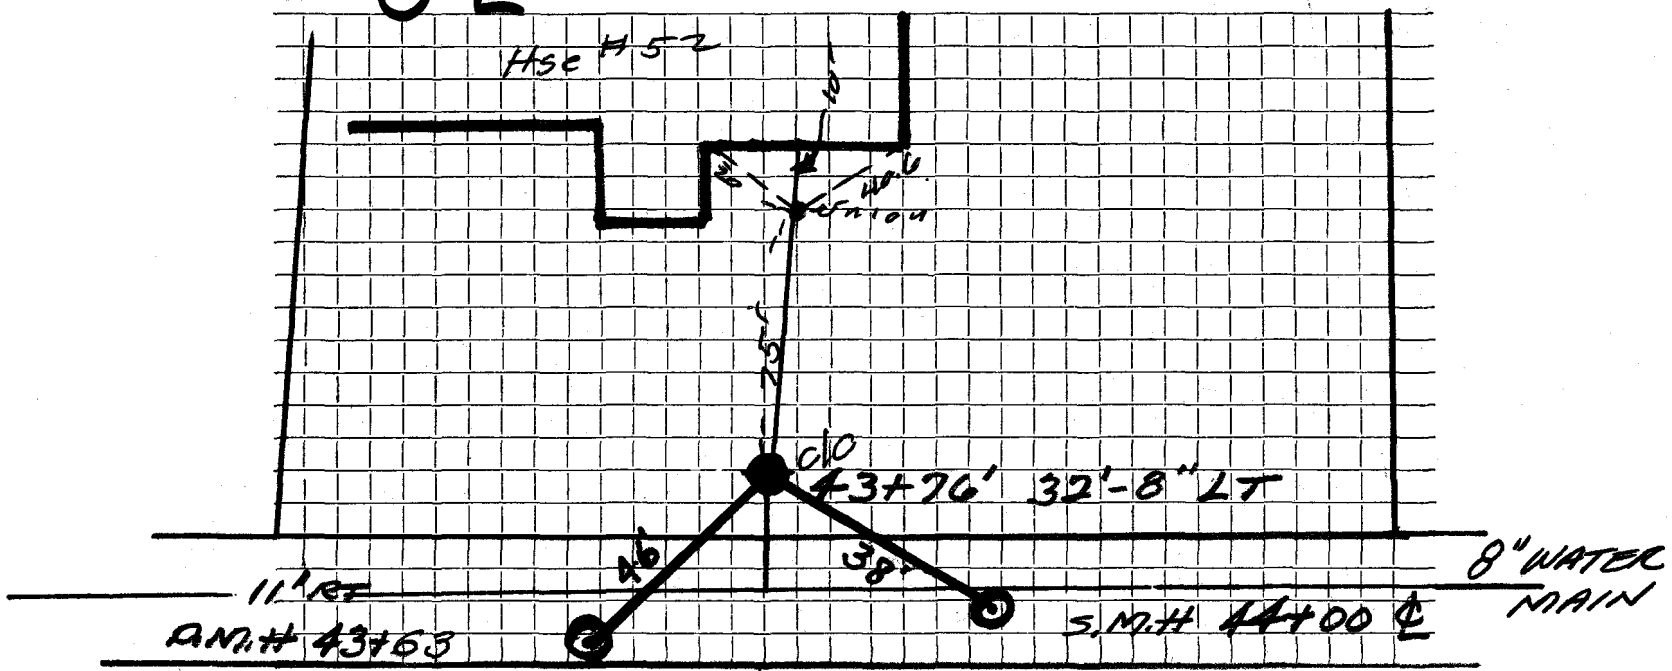

Connection made in ... SOLIMON PIERCE Street. Work completed .....

Remarks: .. WATER TAP = STATION 43+76 : 26' LT .....