

WATER SERVICE RECORD

Name *Dec Builders*

Service No.

Address *53 SOLOMON PIERCE ROAD Lot 63*

Location *PHEASANT BROOK ESTATES*


Repair—Renewal New Service Scire #4283

Date	Material	Amount	Total	Date	Amount
11/11	1" TYPE K COPPER 1" COER 1" CURB w/BOX		NC		
	49.5 LF 1" COPPER			41' 1" Copper	
				1 1" C. Corp Cock	
				1 1" C. Curb Cock	
				1 Box	

DATE _____

TOWN OF LEXINGTON — BOARD OF PUBLIC WORKS

WATER DIVISION

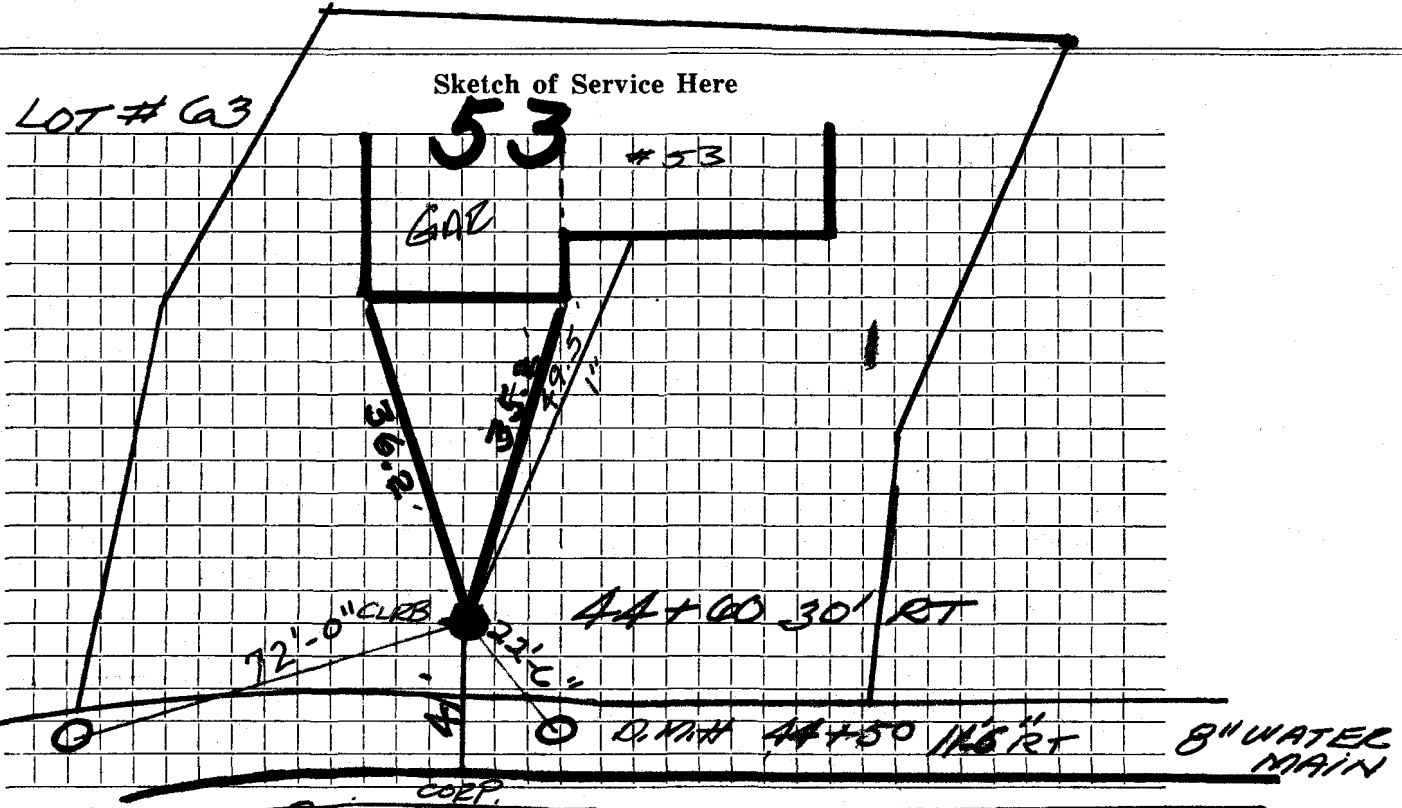

Connection made in SOLOMON PIERCE Street. Work completed

Remarks: TAP = STA 44+60 10' LT