


DATE _____

TOWN OF LEXINGTON — BOARD OF PUBLIC WORKS

WATER DIVISION

Sketch of Service Here

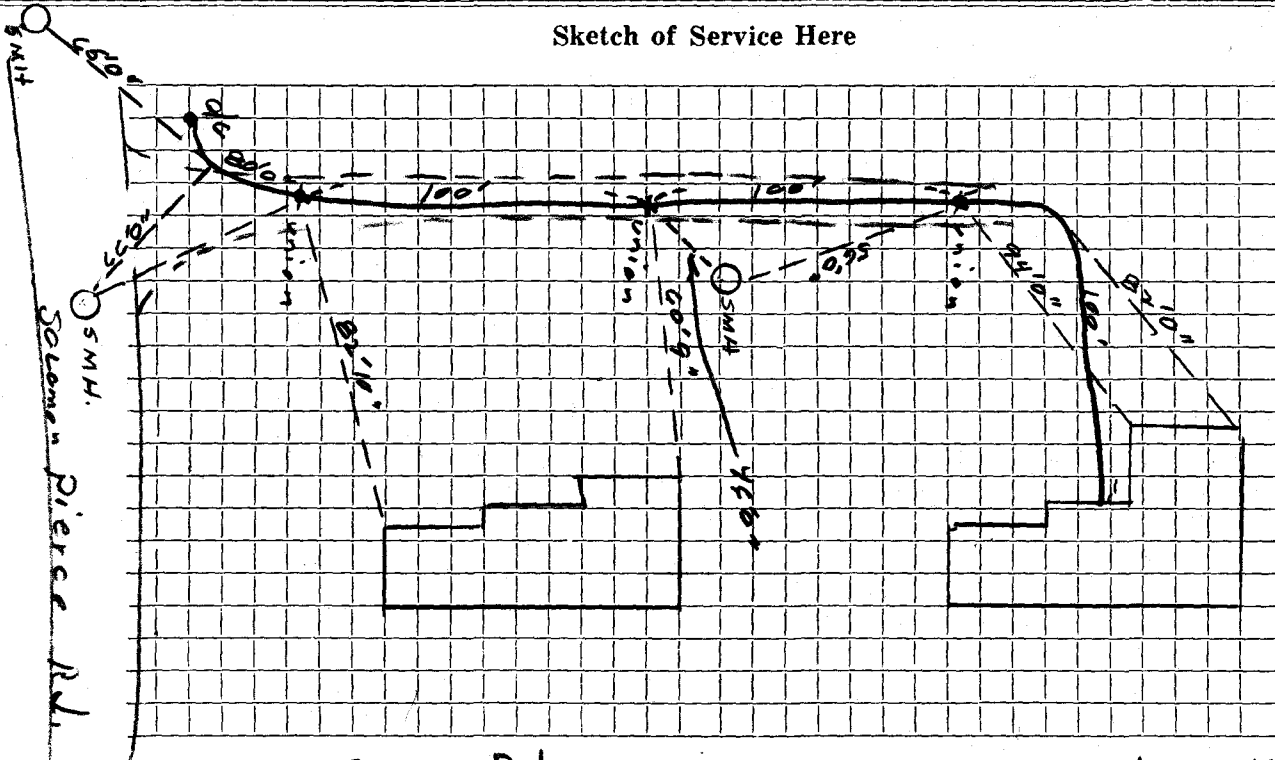

Connection made in Salem Pierce Rd Street

Work completed Oct. 30, 1986

Remarks:

.....

.....