


TOWN OF LEXINGTON — BOARD OF PUBLIC WORKS

WATER DIVISION

Sketch of Service Here

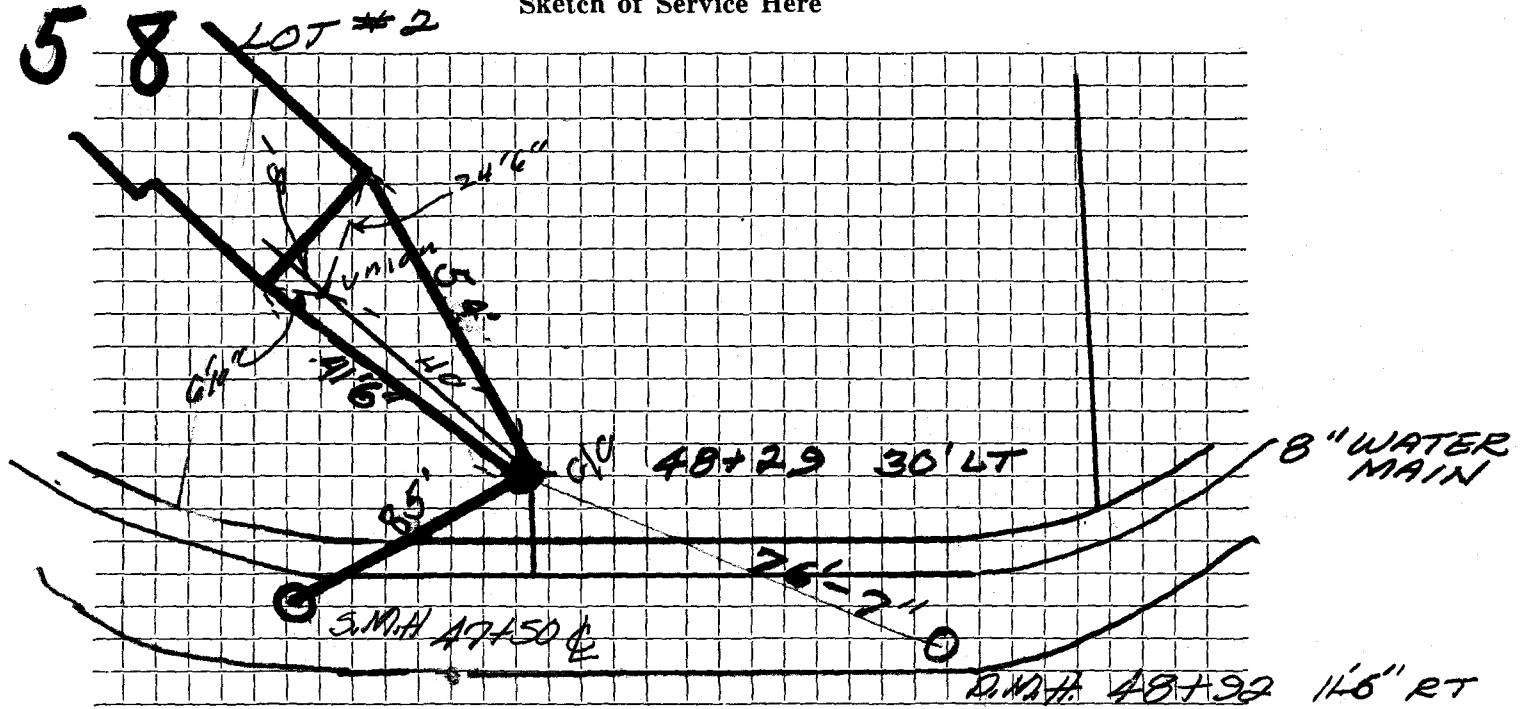

Connection made in COLONON PIERCE Street. Work completed

Remarks: WATER TAP = 48+29 ~~10' LT~~