


DATE _____

TOWN OF LEXINGTON — BOARD OF PUBLIC WORKS

WATER DIVISION

Sketch of Service Here

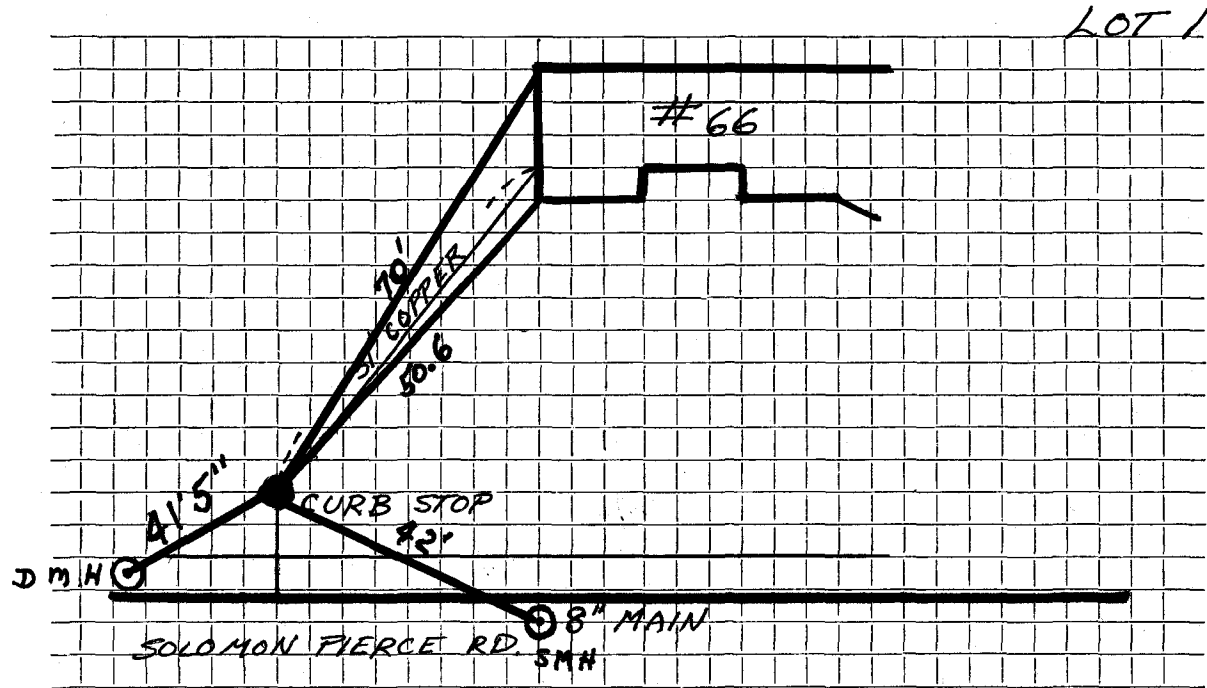

Connection made in : SOLOMON FIERCE RD. Street.

Work completed


Remarks: NO... OUTSIDE... TIES

DATE _____

TOWN OF LEXINGTON — BOARD OF PUBLIC WORKS

WATER DIVISION

Sketch of Service Here

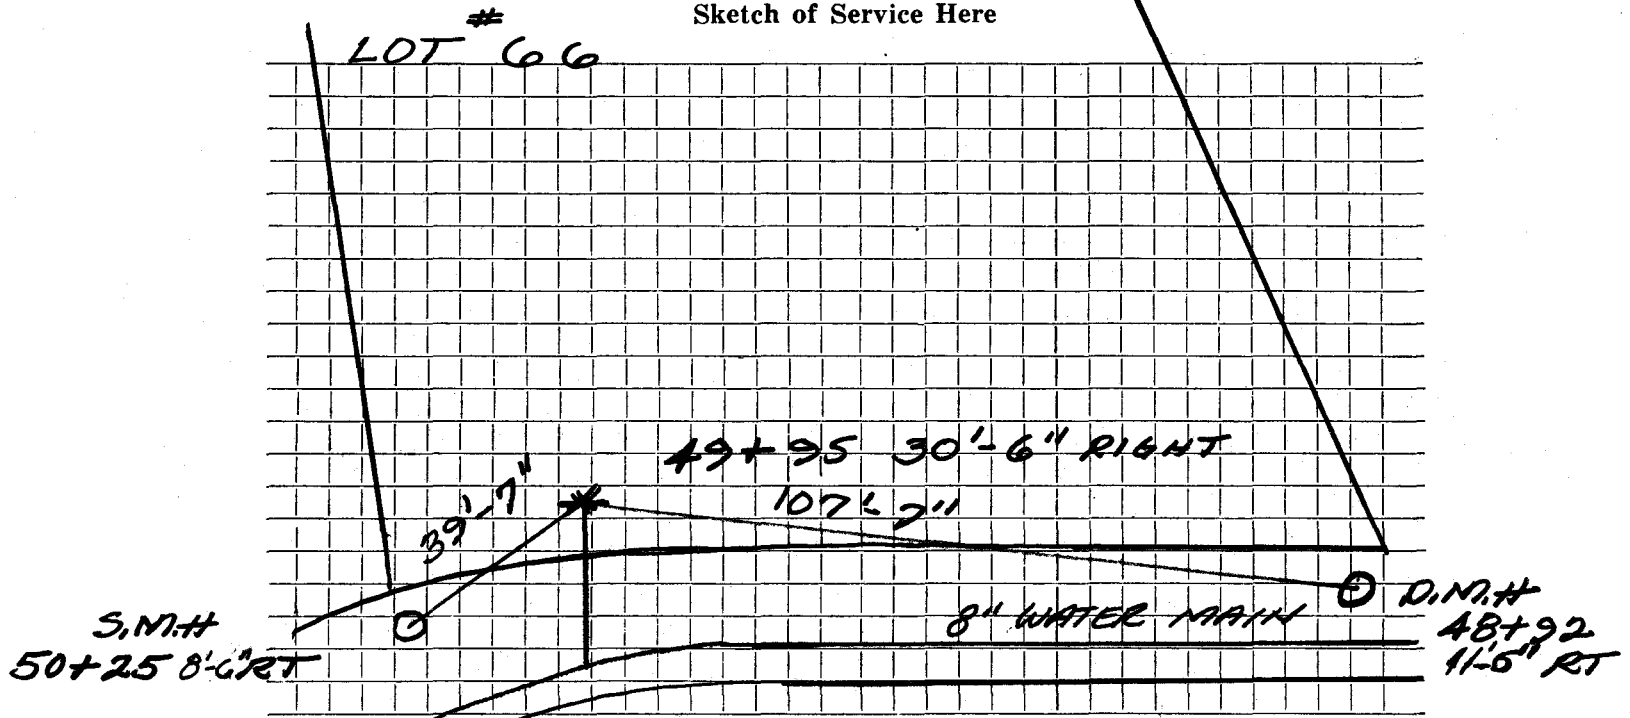

Connection made in SOLDANON PIERCE Street. Work completed

Remarks: TAP = O.T.A. 49+95 10' LT