




DATE \_\_\_\_\_

TOWN OF LEXINGTON — BOARD OF PUBLIC WORKS

WATER DIVISION

LOT # 67

Sketch of Service Here

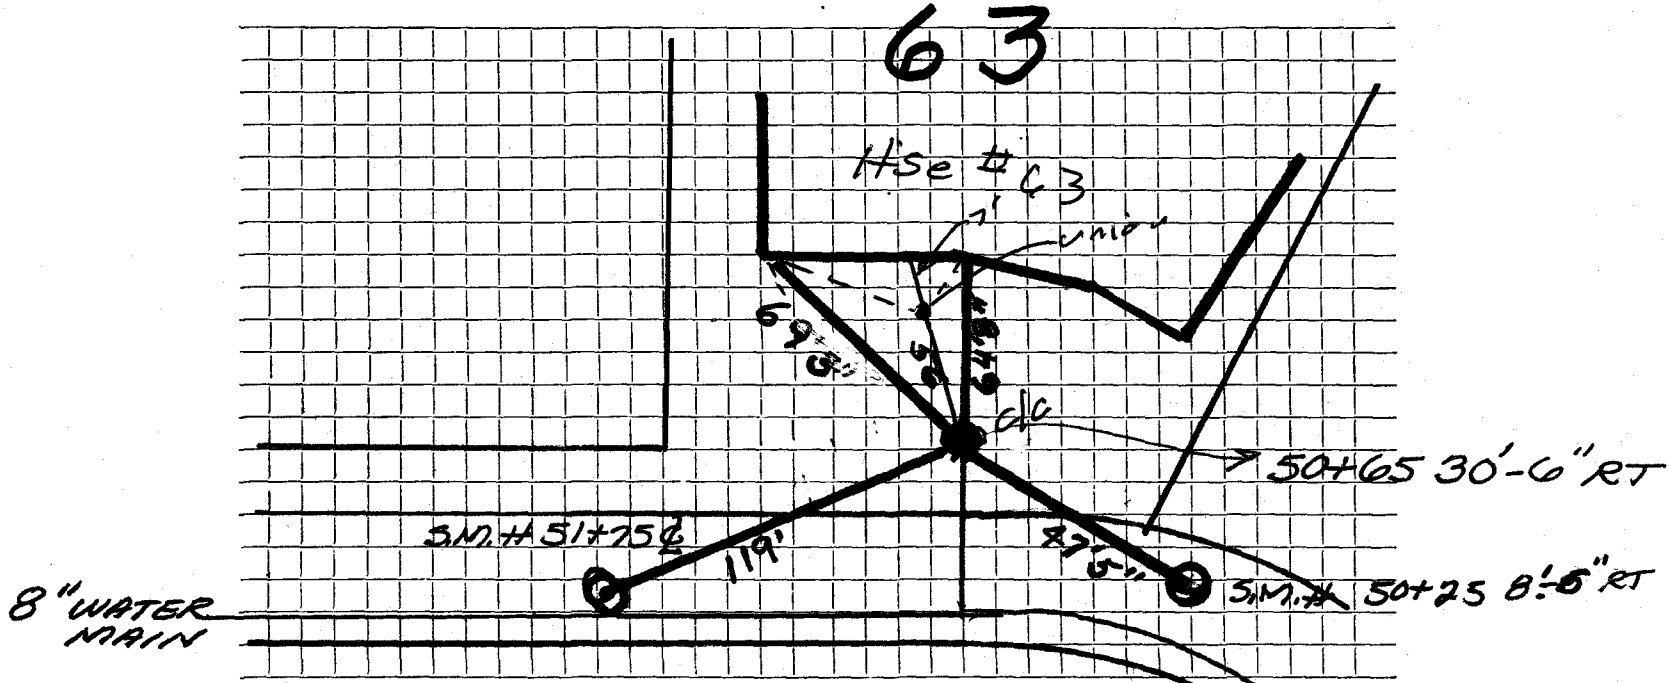

Connection made in SOLDIERS PIERCE street. Work completed .....

Remarks: WATER MAIN STATION = 50+65 : 10' LT