




DATE \_\_\_\_\_

TOWN OF LEXINGTON — BOARD OF PUBLIC WORKS

WATER DIVISION

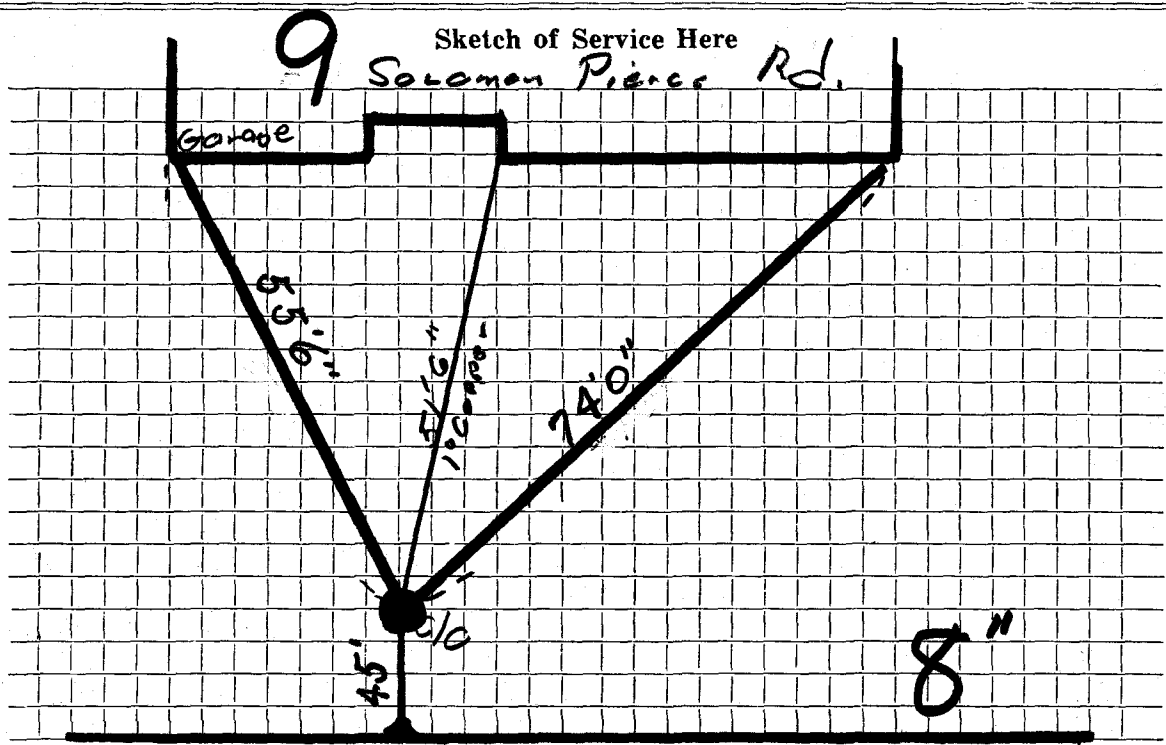

Connection made in Solomon Pierce Rd Street

Work completed ... 12/12/86 .....

Remarks: .....

.....

.....