


TOWN OF LEXINGTON — BOARD OF PUBLIC WORKS

WATER DIVISION

Sketch of Service Here

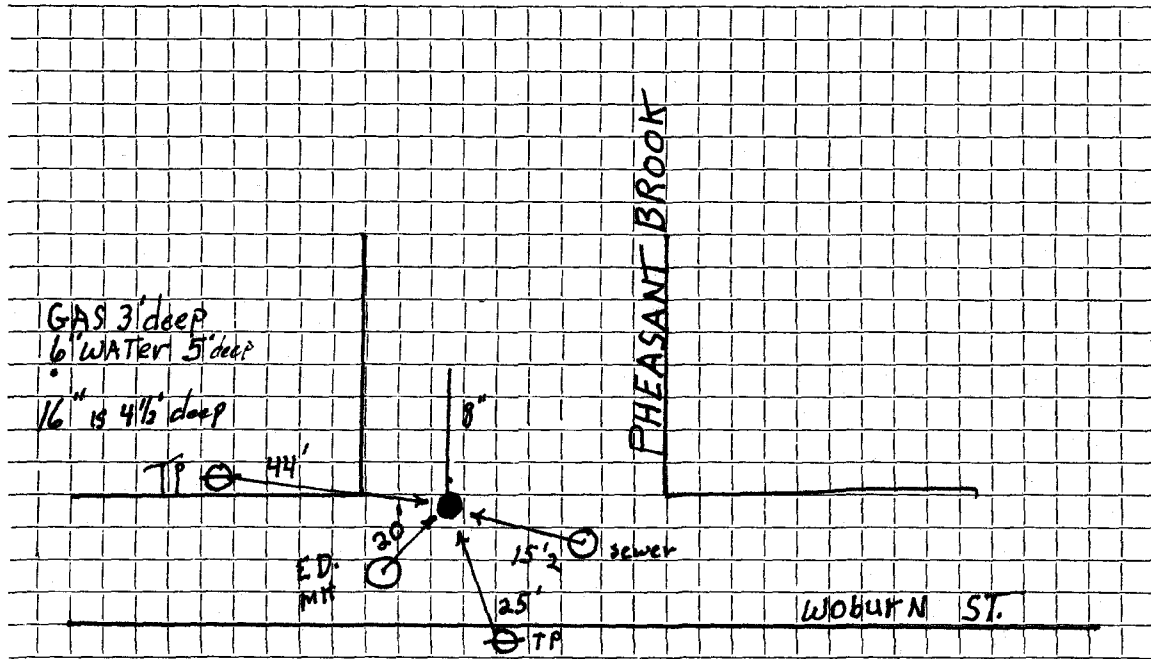

Connection made in PHEASANT BROOK Street. Work completed

Remarks: 16" X 8" T S + G

Gas on top of 6" water - 16" (5' outside 6")