

Name James MacKay *Mr. Appleby*

Service No. *# 440*  
257

Address 14 Somerset Road

Lexington, Mass.

Locatio 14 Somerset Toad

Kind of Pipe *863-1336*

Size

Size of Main

~~Repair~~ ~~Renewal~~ ~~New Service~~

Com. 11-6-50

Location

Date	Material	Amount	Total	Date	Amount
Aug. 25, '50	Labor	2 75	2 75	<i>Aug 21 '50 Deposited</i>	63 00
	10% Overhead		28		
	46' - 3/4" Copper Tubing @.275		12 65		No Charge 40 72
	1 - 3/4" C x 1/2" I.W.H. S&W		3 29	Aug. 25, '50	Labor 8 35
	Littlefield Shovel 3 hrs. @7.00		21 00	12' - 3/4" Copper Tubing @.275	3 30
	Trucking 1 hr. @.75		75	1 - 3/4" C Corp-cock	3 15
			40 72	1 - 3/4" C x 3/4" C Curb-cock	3 85
				1 - Box & Rod	3 35
				1 - 1/8" Offset Tail Piece	42
				1 - 1/2" Straight Tail Piece	42
				Littlefield Shovel 1 hr. @ 7.00	7 00
				Trucking 1 hr. @.75	75
	Labor				30 59

Hadley Press, Inc., Lexington

DATE \_\_\_\_\_

# TOWN OF LEXINGTON—BOARD OF PUBLIC WORKS

## WATER DIVISION

The undersigned applies for a supply of water at No. \_\_\_\_\_ St. and hereby agrees to comply with the rules and regulations as now, or at any future time, established by the Board of Selectmen.


Am't. of Estimate \$ \_\_\_\_\_

Owner \_\_\_\_\_

Am't. Paid \$ \_\_\_\_\_

Address \_\_\_\_\_

Builder \_\_\_\_\_

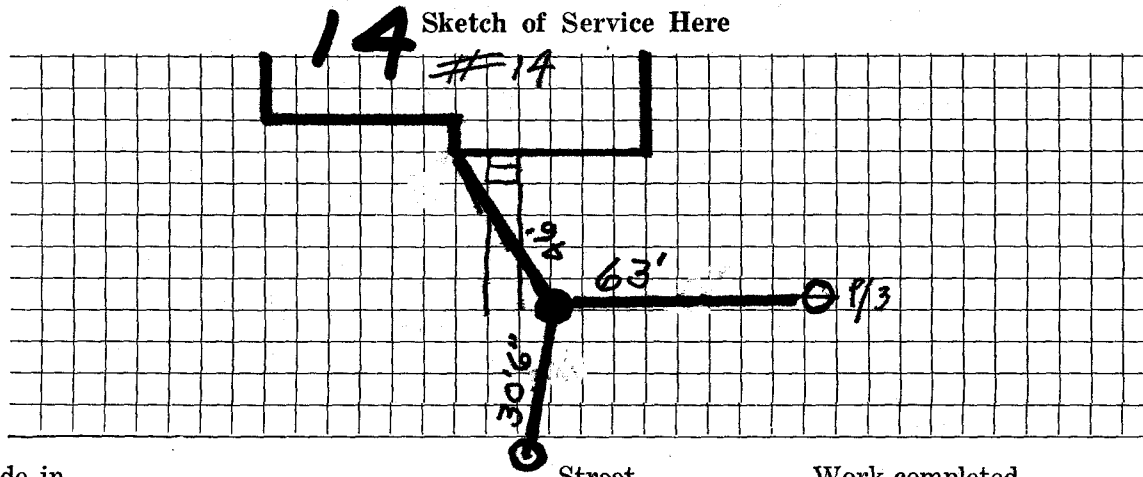

Connection made in \_\_\_\_\_ Street.

Work completed \_\_\_\_\_ 19

Remarks:

ISLAND