

WATER SERVICE RECORD

Name

WHITTEMORE

Service No.

Address

15 SOMERSET

Location

Repair—Renewal—New Service

RENEWAL


Date		Material	Amount	Total	Date	Amount
5/6	96	55' OF 1" COPPER				
					11-7-52	
					65' 3/4" Copper	
					1 3/4" C. Corp Cock	
					1 3/4" C. X 3/4" C. Curb Cock	
					1 Box + Rod	

DATE 5/6/96

TOWN OF LEXINGTON — BOARD OF PUBLIC WORKS

WATER DIVISION

Sketch of Service Here

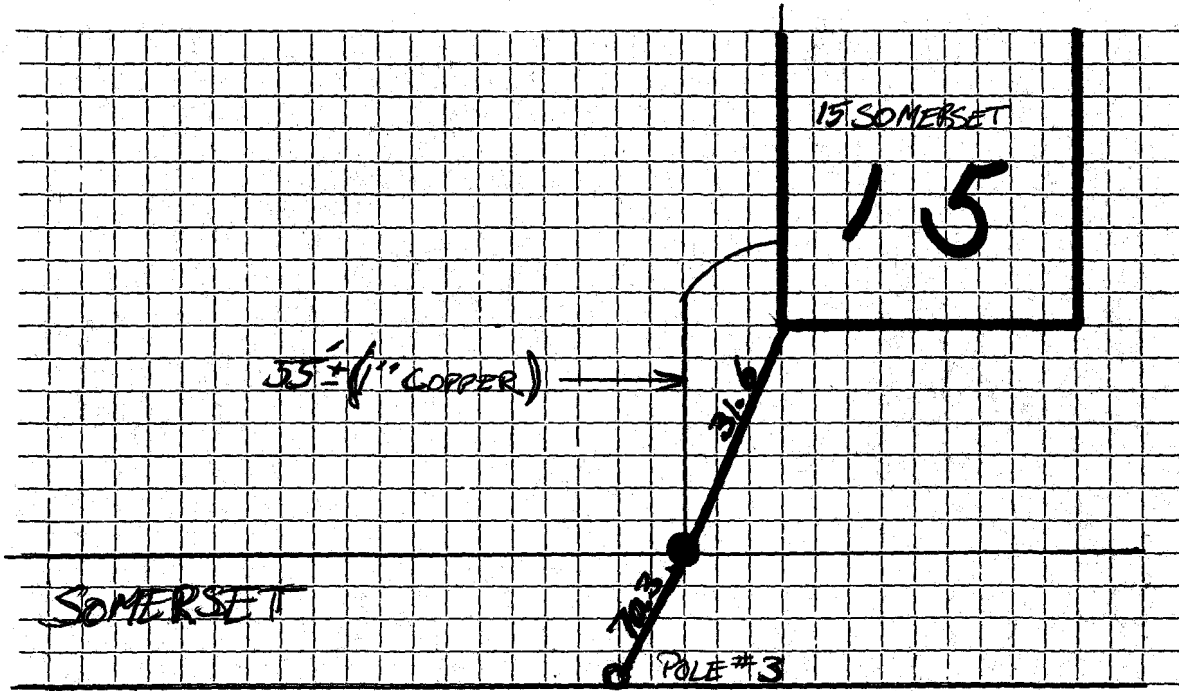

Connection made in Street. Work completed

Remarks: Original Service 11-7-52