

**WATER SERVICE RECORD**

Name Robert M. Fano

Service No. 116

Address 17 Somerset Road

3050

Location Lexington, Mass.

~~Repair~~ ~~Renewal~~ New Service

Com. 8-6-51


Date	Material	Amount	Total	Date		Amount
6-13-51	Labor	1 65	1 65	June 4 '51	Deposited	40 00
	10% Overhead		17			
	151' - 3/4" Copper Tubing @ .326	49 23			No Charge	
	1 - 3/4" C x 1/2" I.W.H. S&W		4 00	6-13-51	Labor	1 65
	2 - 3/4" C x 3/4" C Unions (3pts)		3 44		79' - 3/4" Copper Tubing @ .326	25 75
	Trucking 1 hr. @ .75		75		1 - 3/4" Corp-cock	4 33
			59 24		1 - 3/4" C x 3/4" C Curb-cock	4 67
					1 - Box & Rod	4 68
					1 - 1/2" Offset Tail Piece	50
					1 - 1/2" Straight Tail Piece	50
					Trucking 1 hr. @ .75	75
						42 83

DATE 6-29-1999

TOWN OF LEXINGTON — BOARD OF PUBLIC WORKS

WATER DIVISION

Sketch of Service Here

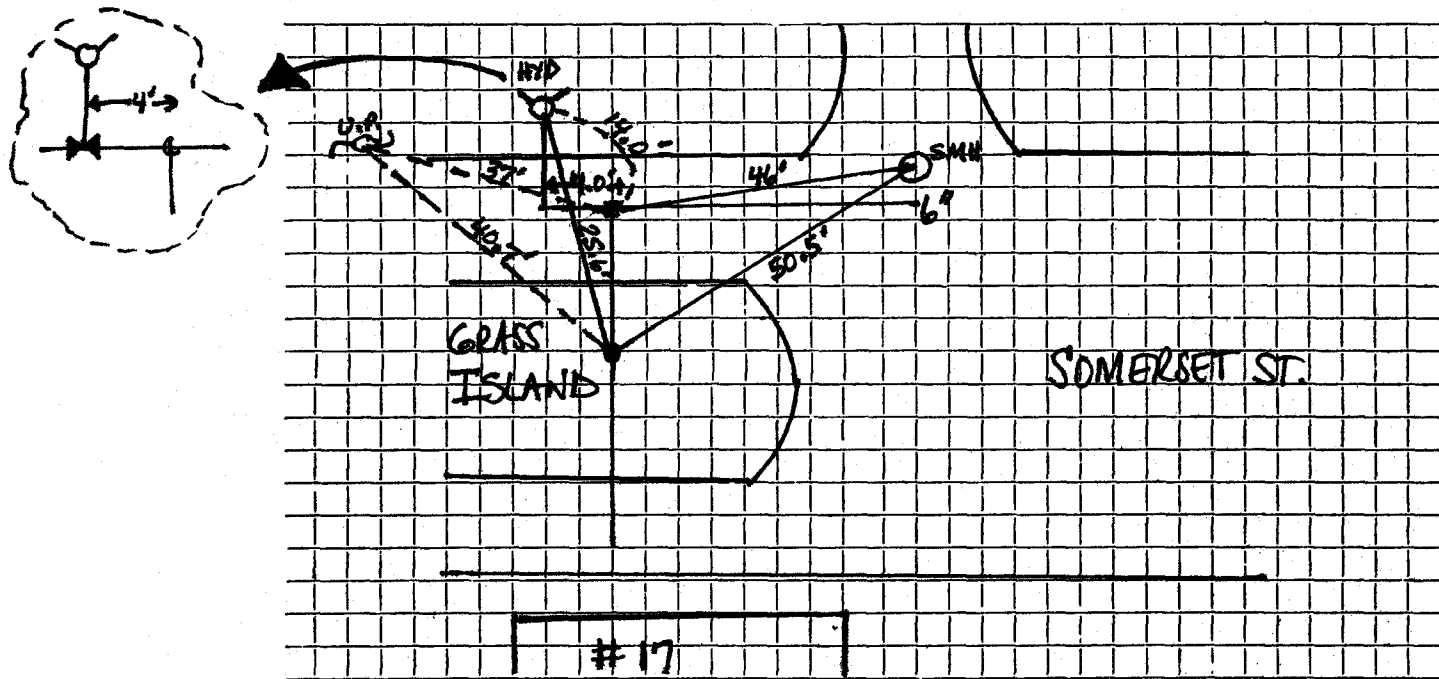

Connection made in 6" MAIN ACROSS ISLAND ..... Street. Work completed NEW CORPORATION, CURBSTOP/BOX .....

Remarks: CURBSTOP/BOX IN GRASS ISLAND. ....