

WATER SERVICE RECORD

Name Louis Stoico

Service No. 156

Address 23 Somerset Road

Location

~~Renewal~~ New Service WO #7708

Comm 1-14-63


Date	Material	Amount	Total	Date	Amount
11-20-62	Labor	1.86		11-5-62	Deposit 25.00
	10% O.H.	.19	2.05	1-14-63	Refund 3.68
55'	3/4" Copper tubing @.42		23.10		71.32
1	3/4" C $\frac{1}{2}$ I.W.H. Stop & Waste		6.17		NON CHARGE
40 x 3	Patch		<u>40.00</u>	11-20-62	Labor 1.86
			71.32	57'	3/4" Copper tubing @.42 23.94
				1	3/4" C Curb Cock 6.28
				1	3/4" C Corp Cock 4.91
				1	Box & Rod 4.90
				1	$\frac{1}{2}$ Straight tailpiece .50
				1	$\frac{1}{2}$ Offset tailpiece .50
					<u>42.89</u>

DATE _____

TOWN OF LEXINGTON — BOARD OF PUBLIC WORKS

WATER DIVISION

Sketch of Service Here

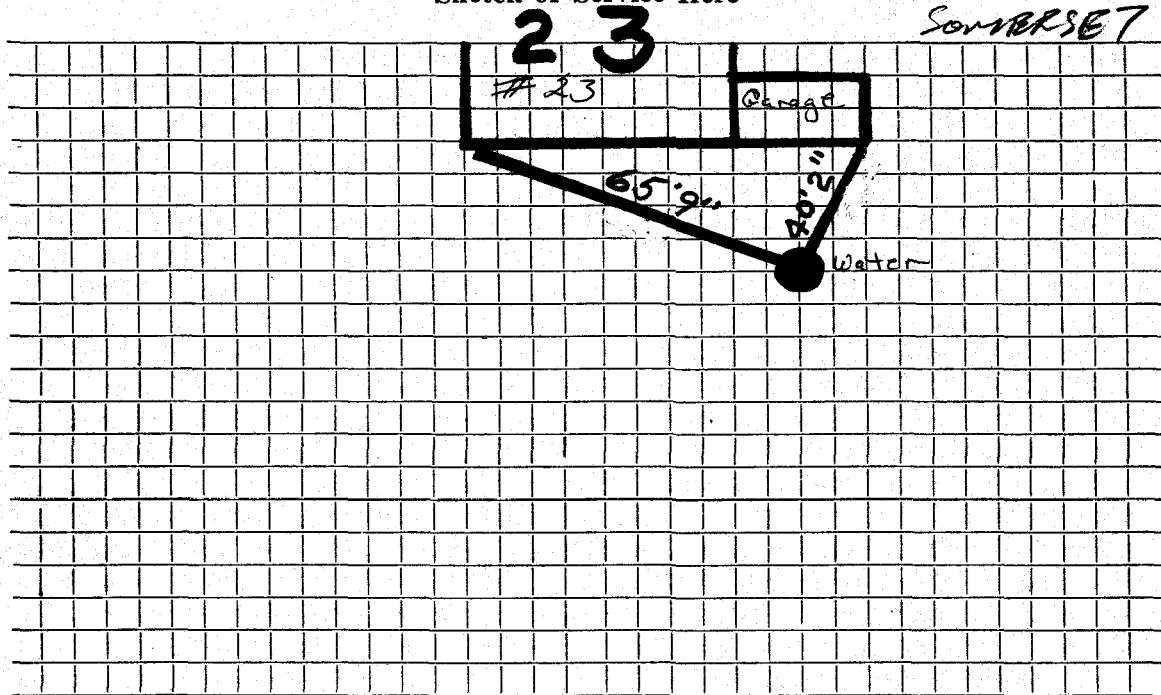

SOMERSET

Connection made in Street. Work completed

Remarks:

.....

.....