

Name Woodruff Estate, (E.M. Collins, Plumber)

Service No. # 2529

Address 24 Somerset Road,

# 6053

Location

Kind of Pipe

Size

Size of Main

~~Repair—Renewal—New Service~~

Location

Date	Material	Amount	Total	Date	Location	Amount
Com 12-8-36	Tapping Main		10 00	Oct. 10, 1936	Repositioned	36 00
12 66	Trench Repairs		2 66	Dec 9, 1936	Repositioned	23 34
			12 66			12 66
	3/4 Copper Outside Checked 10-22-90 Labor					

Hadley Press, Inc., Lexington

TOWN OF LEXINGTON—BOARD OF PUBLIC WORKS  
WATER DIVISION

The undersigned applies for a supply of water at No. 24 Somerset Rd St. and hereby agrees to comply with the rules and regulations as now, or at any future time, established by the Board of Selectmen.

24' @ \$1.10

Am't. of Estimate \$ 36.00

Am't. Paid \$ \_\_\_\_\_

Builder \_\_\_\_\_

Owner

Woodruff Est.


Address

24 Somerset Rd

Lexington

Ray C McCallina

Sketch of Service Here

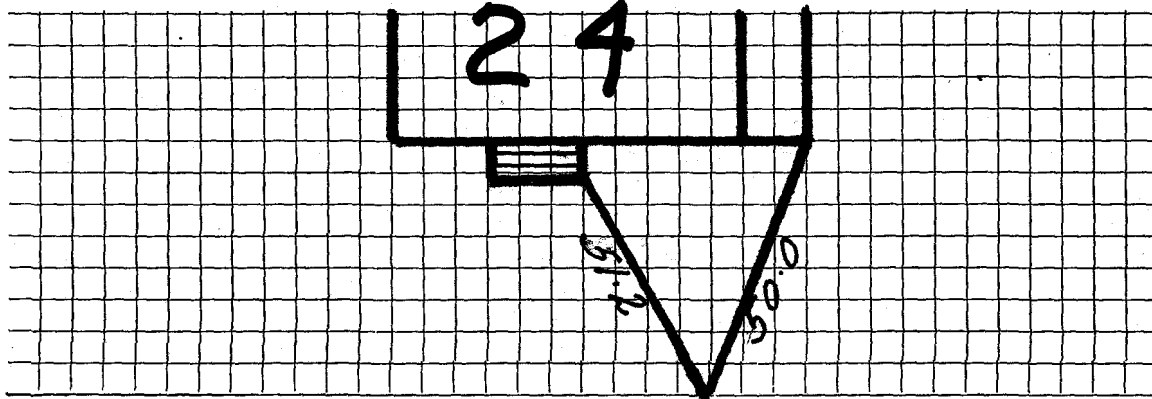

Connection made in \_\_\_\_\_ Street.

Work completed \_\_\_\_\_ 19

Remarks: