

Name Philip M. Clark

Service No. ~~62~~ 2530

Address

~~25~~ Somerset Road ~~or 35 Hancock~~

Location

Kind of Pipe

Size

Size of Main

~~Repair—Renewal—New Service~~

Location

Date
1941

Material

Amount

Total

Date

Amount

June 4,

59½ hrs. @ 50¢

29 75

July 1, 1941 Paid

117 10

42½ " @ 60¢

25 50

25 " @ 65¢

16 25

2 " @ 70¢

1 40

72 90

10% Overhead

7 29

123' 1" Copper tubing @ 22¢

27 06

1 1" S. & W.

2 35

1 1" Brass elbow

1 30

2 1" Space Nipples @ .35

70

2 1" C. Unions (3 part) @ 1.15

2 30

Bill sent June 24, 1941

1 1" C. x 1" I. Union

65

1 1" x 3/4" Bushing

30

Trucking- 3 hrs. @ 75¢

2 25

Labor

117 10

DATE _____

TOWN OF LEXINGTON—BOARD OF PUBLIC WORKS

WATER DIVISION

The undersigned applies for a supply of water at No. _____ St. and hereby agrees to comply with the rules and regulations as now, or at any future time, established by the Board of Selectmen.

Am't. of Estimate \$ _____

Owner _____


Am't. Paid \$ _____

Address _____

Builder _____

SERVICE IN BRANCH OF HOUSE

Sketch of Service Here

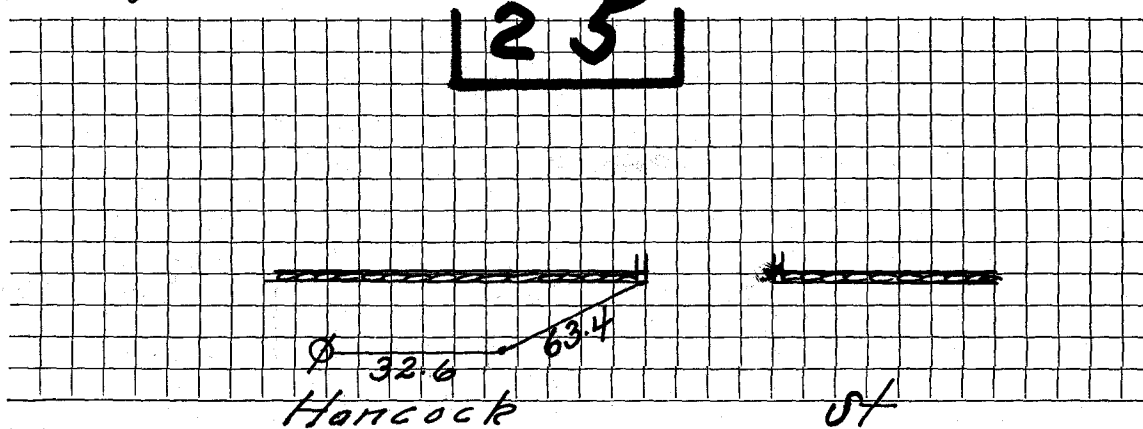

Connection made in _____ Street.

Work completed _____ 19

Remarks: