

Name Harry A. Wheeler

Service No. ~~43~~ 2532

Address 31 Somerset Road

5746

Location

Kind of Pipe

Size

Size of Main

~~Repair~~—Renewal—~~New Service~~ x

Location

Date

Material

Amount

Total

Date

Amount

*Can 12836
28⁰⁰*

Tapping Main
Trench Repairs

10 00
18 00

28 00

*Oct 7 1936
Dec 9 1936*

*Deposited
Refunded*

60 00
32 00
28 00

*Inside
1" Copper*

*Outside
1" Copper.*

Labor

DATE October 15, 1936

TOWN OF LEXINGTON—BOARD OF PUBLIC WORKS
WATER DIVISION

The undersigned applies for a supply of water at No. 31 Somerset Road St. and hereby agrees to comply with the rules and regulations as now, or at any future time, established by the Board of Selectmen.

Am't. of Estimate \$ 60⁰⁰

Owner

Harry A. Wheeler


Am't. Paid \$ _____

Address

Builder _____

By, William Lenson

Sketch of Service Here

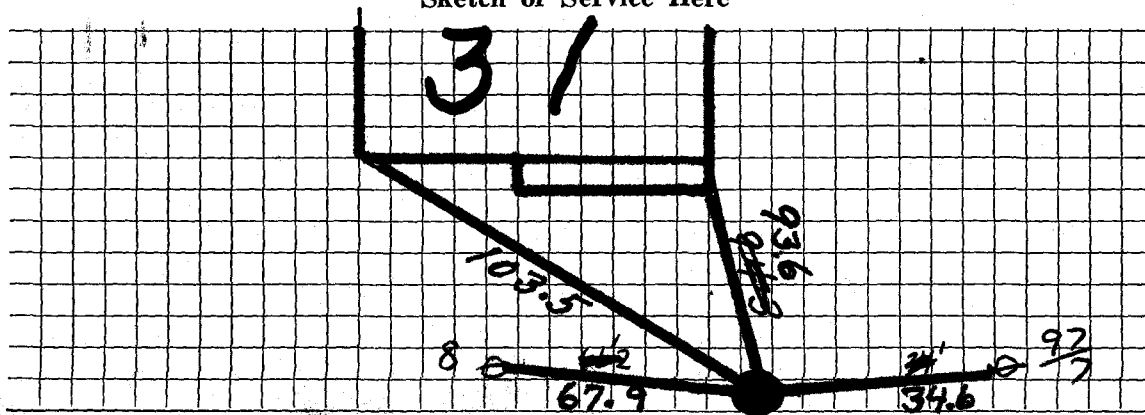

Connection made in _____ Street.

Work completed _____ 19

Remarks:

Checked
10-25-90 1" Copper