

**WATER SERVICE RECORD**

Name James Seaver

Service No. 66

Address 37 Somerset Road

Location

~~Repair~~ ~~Renewal~~ ~~New Service~~ W.O.#7528

JAN 27 1969


Date	Material	Amount	Total	Date	Amount
10/22/68	Labor	100 64		10-16-68	350 00
10/25/68	"	25 16	125 80	1-27-69	82 46
	10% O.H.		12 58		267 53
70'	3/4" Copper tubing .79		55 30		Labor 121 45
1	1" Union		2 81	33'	Copperpipe .79 26 07
1	1" Wheel Valve		12 53	1	1" Curb Cock 14 43
7	Yds. Loam @ 3.50		24 50	1	1" Corporation 10 66
5	Lbs. Grass Seed @ 1.10		5 50	1	Ton Cold Patch 5 50
3	Hrs. Shovel @ 6.50		19 50	4	" Hot Top @ 5.80 23 20
3	" Trucking @ 3.00		9 00	4	Hr. Trucking @ 3.00 12 00
			267 52	1/3	" Trucking 1 50
				3	" Shovel @ 6.50 19 50
				1/2	" Compressor @ 5.00 2 50
				1/2	" Loader @ 4.00 2 00
				1	" Roller 3 00
					Trailer 2 00
					243 81

DATE \_\_\_\_\_

TOWN OF LEXINGTON — BOARD OF PUBLIC WORKS

WATER DIVISION

Sketch of Service Here

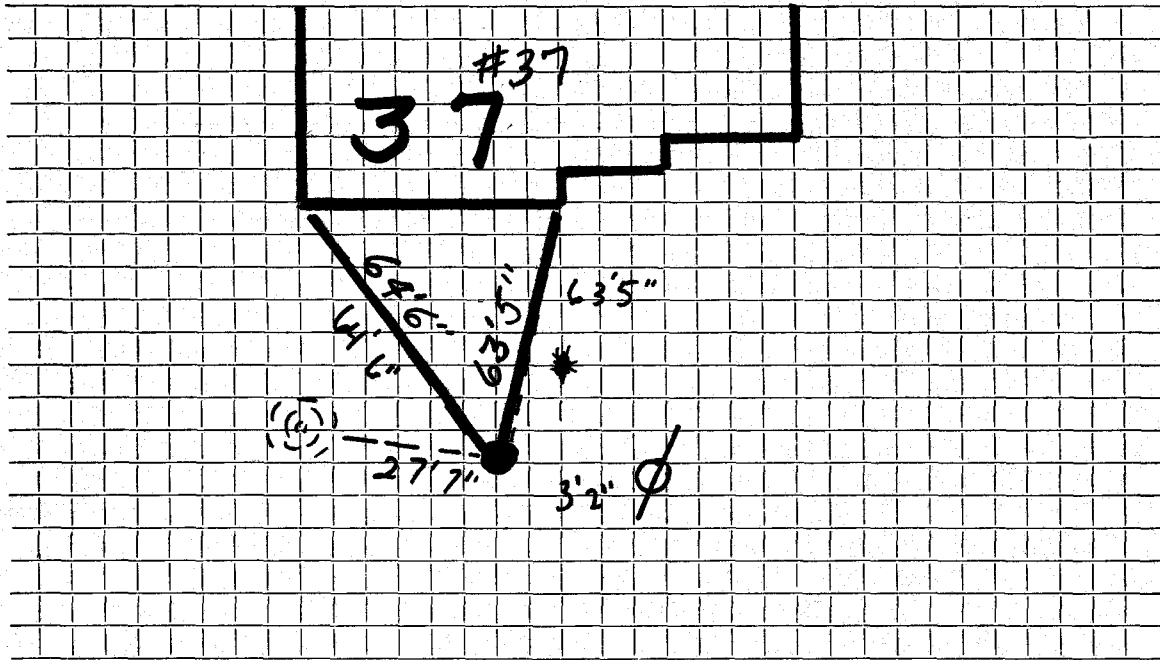

Connection made in ..... Street. Work completed .....

Remarks: .....  
.....  
.....