

Name Marion C. Rowse

Service No. 2534

Address 38 Somerset Road

1914
6984

Location

Kind of Pipe

Size

Size of Main

~~Repair - Renewal~~ - New Service

Location

Date

Material

Amount

Total

Date

Amount

5/2/33

60 ³/₄" C. Pipe @ .12

\$7 20

Com. 72

1 S & W

2 75

6-20-33

Trucking

75

\$8 70

April 25 1933 - Cash

72 -

32 Hrs. Labor @ .55

17 60

24 " " @ .50

12 00

2 " " @ .60

1 20

30 80

15% Overhead

4 62

Cost

44.12

CHARGE

50 Ft. @ \$1.20

\$72 00

\$72 00

Labor

Hay Press, Inc., Lexington

Renewal of service

DATE April 28, 1933

TOWN OF LEXINGTON—BOARD OF PUBLIC WORKS
WATER DIVISION

The undersigned applies for a supply of water at No. 38 Somerset Rd. St. and hereby agrees to comply with the rules and regulations as now, or at any future time, established by the Board of Selectmen.

Am't. of Estimate \$ 72


Owner Maria C. Poirer

Am't. Paid \$ 72

Address 38 Somerset Rd

Builder _____

Sketch of Service Here

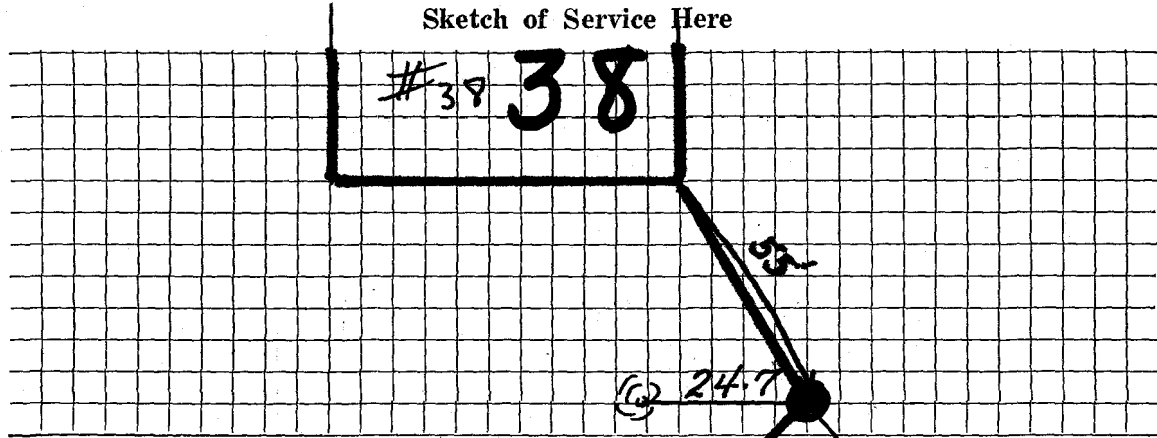

Connection made in _____ Street. Work completed _____ 19

Remarks:

