

Name **Carroll H. Beers**  
 Address **39 Somerset Rd**

Service No. ~~123456~~ **143**

Location **39 Somerset Road**

Kind of Pipe \_\_\_\_\_ Size \_\_\_\_\_ Size of Main \_\_\_\_\_

~~Repair—Renewal—New Service~~

Location **Comm 11-17-58**

Date	Material	Amount	Total	Date	Amount
8/4/58	Labor <del>80x21</del>	60 91		7-22-58	Deposit 125.00
	10% overhead <del>6x09</del>	6 09	67 00	11-17-58	Refund 4.84
	65' 3/4" Copper tubing @.37		24 05		120 16
	1-3/4" Cx 1/2 I.W.H. stop & waste		5 84		NON CHARGE
	1-3/4" C-3part union		2 27	8/4/58	Labor 28 19
	2 hrs. trucking @.75		1 50	30'-3/4" copper tubing @.37	11 10
	3 hrs. hired shovel @ 6.50		19 50	1-3/4" C Adapter	2 08
			120 16	1-3/4" C Curb Cock	6 03
				1 box & rod	5 00
				1-1/2" offset tail piece	50
				2 hrs. hired shovel @ 6.50	13 00
				25 x 3 Patch	25 00
	Labor				90 90

Hadley Press, Inc., Lexington

# TOWN OF LEXINGTON—BOARD OF PUBLIC WORKS

## WATER DIVISION

The undersigned applies for a supply of water at No. \_\_\_\_\_ St. and hereby agrees to comply with the rules and regulations as now, or at any future time, established by the Board of Selectmen.

Am't. of Estimate \$ \_\_\_\_\_

Owner

Peter Robinson


Am't. Paid \$ \_\_\_\_\_

Address

Somerset Rd no 39

Builder \_\_\_\_\_

Sketch of Service Here

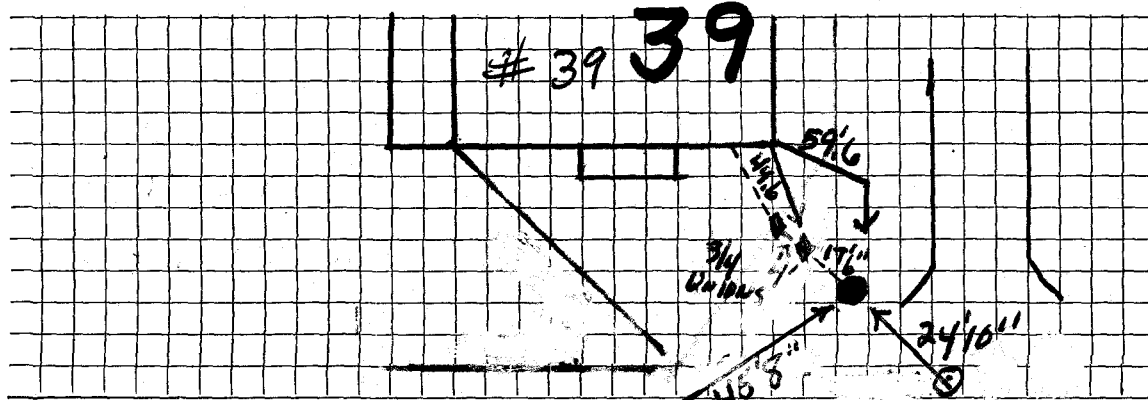

Connection made in 2-3/4 UNIONS IN sewer trench Street. Hyd

Work completed 5MH

Remarks: