

Name William Shurtleff

Service No.

276

Address 41 Somerset Road

Lexington, Mass.

Location 41 Somerset Road

Kind of Pipe

Size

Size of Main

~~Repair~~ Renewal - ~~New Service~~

Location

Date	Material	Amount	Total	Date	Amount
Nov. 26, '48	Labor	45 16	45 16	Nov 10, 1948	100 00
	10% Overhead		4 52	Dec. 31 '48	12 89
	80' - 1" Copper Tubing @.317		25 36		87 11
	1 - 1" C x 3/4" I.W.H. S&W		3 15	Dec. 26, '48	20 37
	1 - 3/4" x 1/2" Bushing		4 00	27	17 00
	1 - 1" C x 1" C Union (3pts)		1 77	28' - 1" Copper Tubing @.317	8 88
	Compressor 3 hrs. @ 1.75		5 25	1 - 1" C Corp-cock	4 52
	Trucking 2 hrs. @.75		1 50	1 - 1" C x 1" C Curb-cock	5 36
			87 11	1 - Box & Rod	3 55
7/28/81	Lower Water Service V.O.#1577			1 - 1/2" Offset Tail Piece	30
	27' 1" Copper tubing			1 - 1/2" Straight Tail Piece	30
	2 ton Crusher Run			Trucking 1 hr. @.75	75
	12 yd Labor Gravel			Patching 25 x 3	25 00
	4 ton Top				86 03

DATE _____

TOWN OF LEXINGTON - BOARD OF PUBLIC WORKS

WATER DIVISION

The undersigned applies for a supply of water at No..... St. and hereby agrees to comply with the rules and regulations as now, or at any future time, established by the Board of Selectmen.

Am't of Estimate \$.....

Owner


Am't Paid \$.....

Address

Builder

.....

Sketch of Service Here

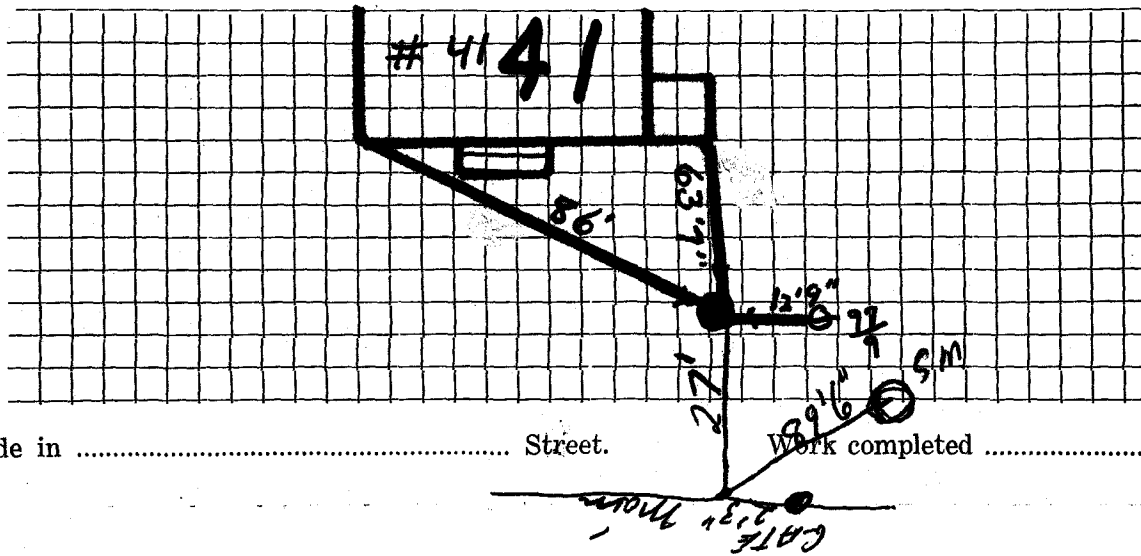

Connection made in Street.

Work completed19

Remarks:

CATE 1131