

WATER SERVICE RECORD

9920
5582
64

Name Leroy Marek

Sandra Gunn 577-8500 x 1370 Service No.

Address 43 Somerset Rd.

PL 2646

Location

Lexington

~~Renewal~~ ~~Not~~ ~~XXXX~~

COM. 6-8-53


Date	Material	Amount	Total	Date	Amount
5/6/53	Labor	74 99		4-1-53 Deposited	125 00
	10% overhead	7 50	82 49	6-8-53 Refunded	6 46
	87'-3/4" Copper Tubing @.34		29 58		NON CHARGE
	1-3/4" C x 3/8 I.W.H. STOP & WASTE		4 00	5/6/53 Labor	20 00
	1-3/4" C x 3/4" C. Union(3 parts)		1 72	5/7/53 Labor	51 15
	1 Hr. Trucking		75	30'-3/4" Copper Tubing @.34	10 20
			118 54	1-3/4" C. Adapter	1 95
				1-3/4" C x 3/4" C. Curb-cock	4 67
				1-Box & Red	3 90
				2 Hr. #36 Compressor @2.75	5 50
				1 Hr. Trucking	75
				Patching 28 x 3	28 00
					126 12

DATE _____

TOWN OF LEXINGTON — BOARD OF PUBLIC WORKS

WATER DIVISION

Sketch of Service Here

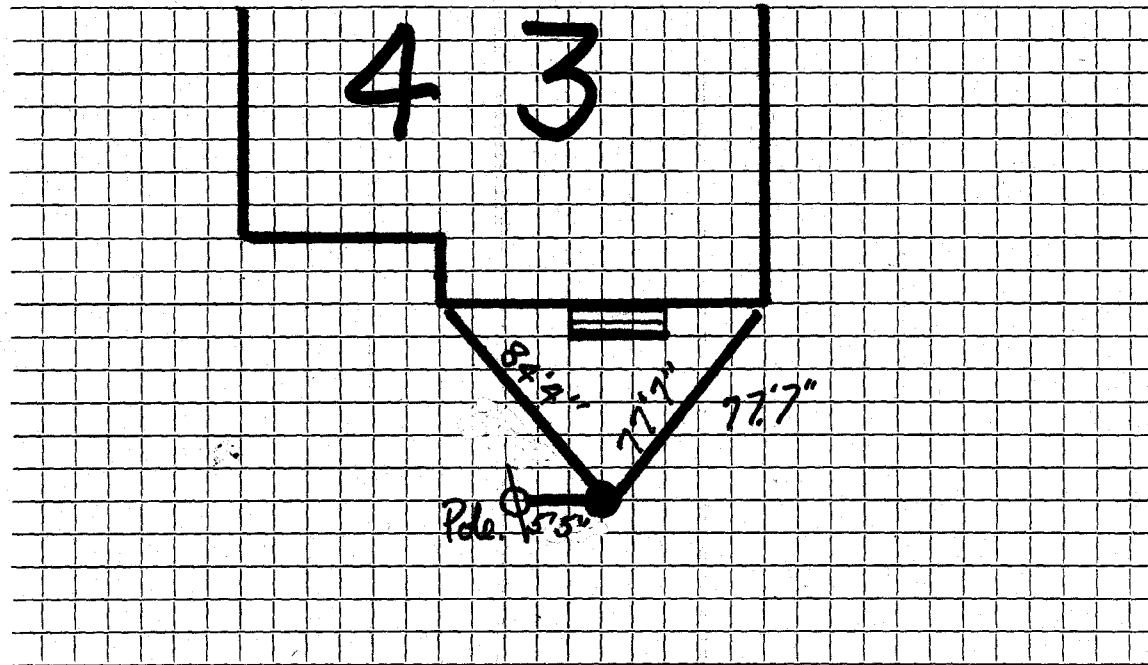

Connection made in Street. Work completed

Remarks:

.....

.....