

Name Gordon Richards

Service No. 7

Address 49 Somerset Road

#7740

Lexington, Mass.

Location 49 Somerset Road

Kind of Pipe

Size

Size of Main

~~RENEWAL~~ New Service Com. 3-7-49

Location

Date	Material	Amount	Total	Date	Amount
Jan. 11, '49	Labor	1 15	1 15	Jan. 10, '49	25 00
	10% Overhead	12	12	Mar 10 '49	3 21
	52' - 1" Copper Tubing		16 12		21 29
	1 - 1" C x 3/4" I.W.H. S&W		3 15	Jan. 11, '49	1 15
	Trucking 1 hr. @.75		75	28' - 1" Copper Tubing	8 68
			21 29	1 - 1" C Corp-cock	4 62
				1 - 1" C x 1" C Curb-cock	4 80
				1 - Box & Rod	3 55
				1 - 3/4" Offset Tail Piece	30
				1 - 3/4" Straight Tail Piece	30
				Trucking 1 hr. @.75	75
					24 15
	Labor				

DATE _____

TOWN OF LEXINGTON - BOARD OF PUBLIC WORKS

WATER DIVISION

The undersigned applies for a supply of water at No. St. and hereby agrees to comply with the rules and regulations as now, or at any future time, established by the Board of Selectmen.

Am't of Estimate \$.....


Owner

Am't Paid \$.....

Address

Builder

.....

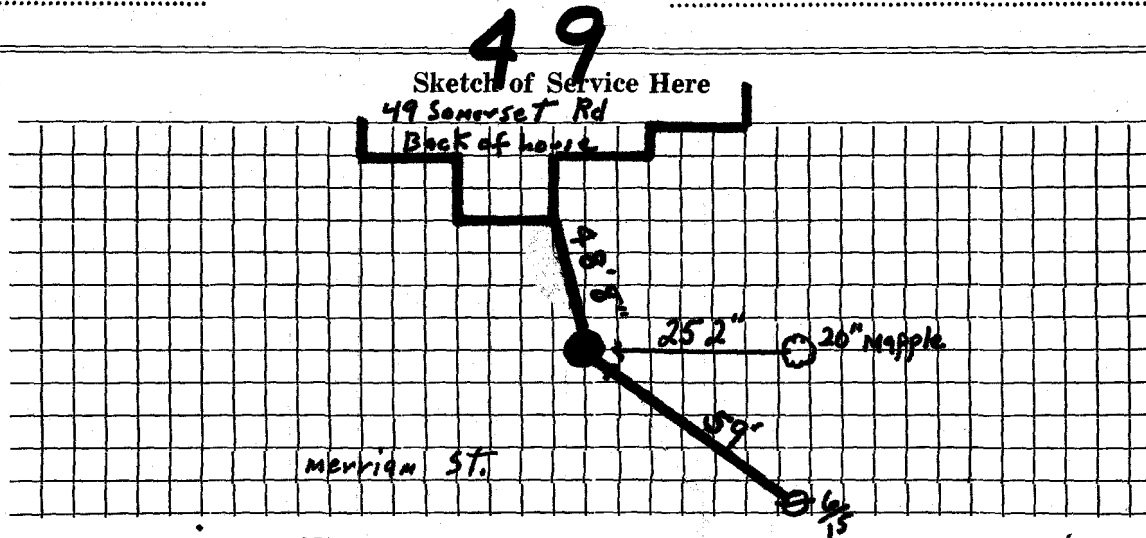

Connection made in Merrim St Street.


Work completed19

Remarks:

DATE 6-25-1999

TOWN OF LEXINGTON — BOARD OF PUBLIC WORKS
WATER DIVISION

Sketch of Service Here

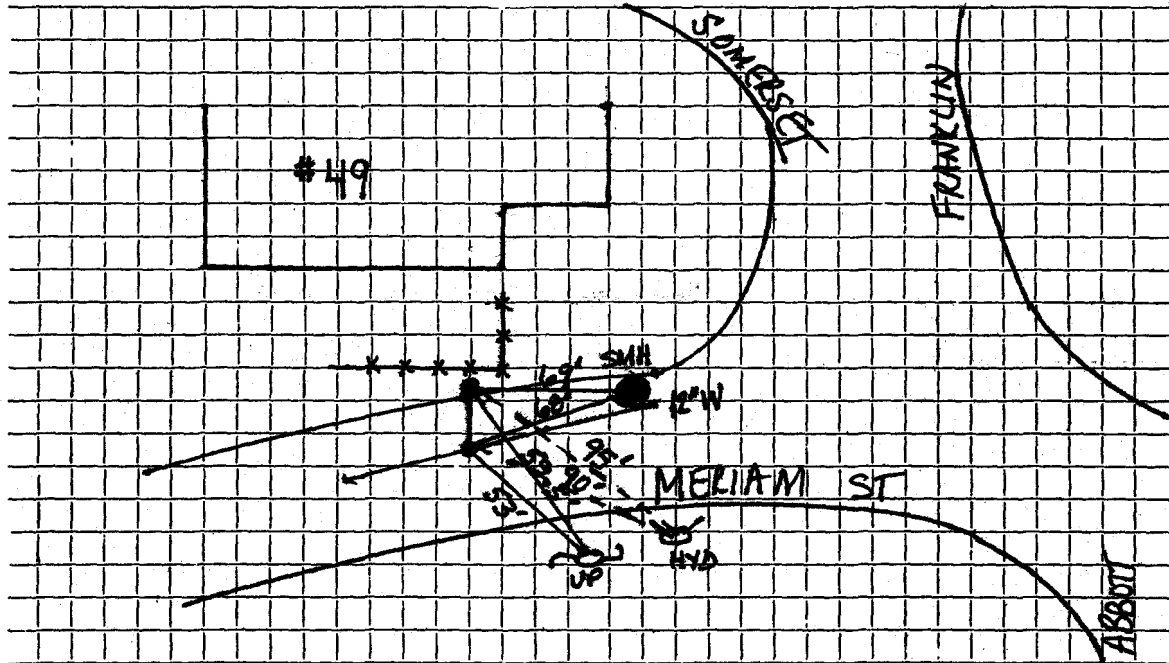

	HD	V.P.	SMH
Curb Stop/Box	95'	59.5'	69'
Connection	90'	53'	68'

Connection made in Street. Work completed .. NEW CORPORATION, CURBSTOP/BOX

Remarks: -SERVICE TO # 49. SOMERSET GOES TO 12" MAIN ON MELIAM [BACK OF HOUSE]

-BOX IN GLASS AREA BTW SIDEWALK & ROAD.