

WATER SERVICE RECORD

5723

Name **A. J. Comeau**

Service No.

112

Address **50 Somerset Road**

Location **Lexington**

~~Repair~~ ~~Renewal~~ - New Service

Com. 9-22-52


Date	Material	Amount	Total	Date	Amount
8/20/52	Labor	1 80		6-19-52	Deposited 50 00
	10% overhead	18	1 98	9-22-52	Refunded (3 38)
	106' - 3/4" copper tubing@.3439		36 45		<u>NON CHARGE</u> 46 62
	1 - 3/4" C x 1/2 I.W.H. stop & waste		4 00	8/20/52	Labor 1 80
	2 - 3/4" C x 3/4" C. unions 3 pts.		3 44	42' - 3/4" Copper tubing@.3439	14 44
	1 hr. trucking		75	1 - 3/4" C. corp-cock	4 33
			46 62	1 - 3/4" C x 3/4" Curb-cock	4 67
				1 box and rod	3 90
				1 - 1/2 straight tail piece	50
				1 - 1/2 offset tail piece	50
				1 hr. trucking	75
					<u>30 89</u>

DATE _____

TOWN OF LEXINGTON — BOARD OF PUBLIC WORKS

WATER DIVISION

Sketch of Service Here

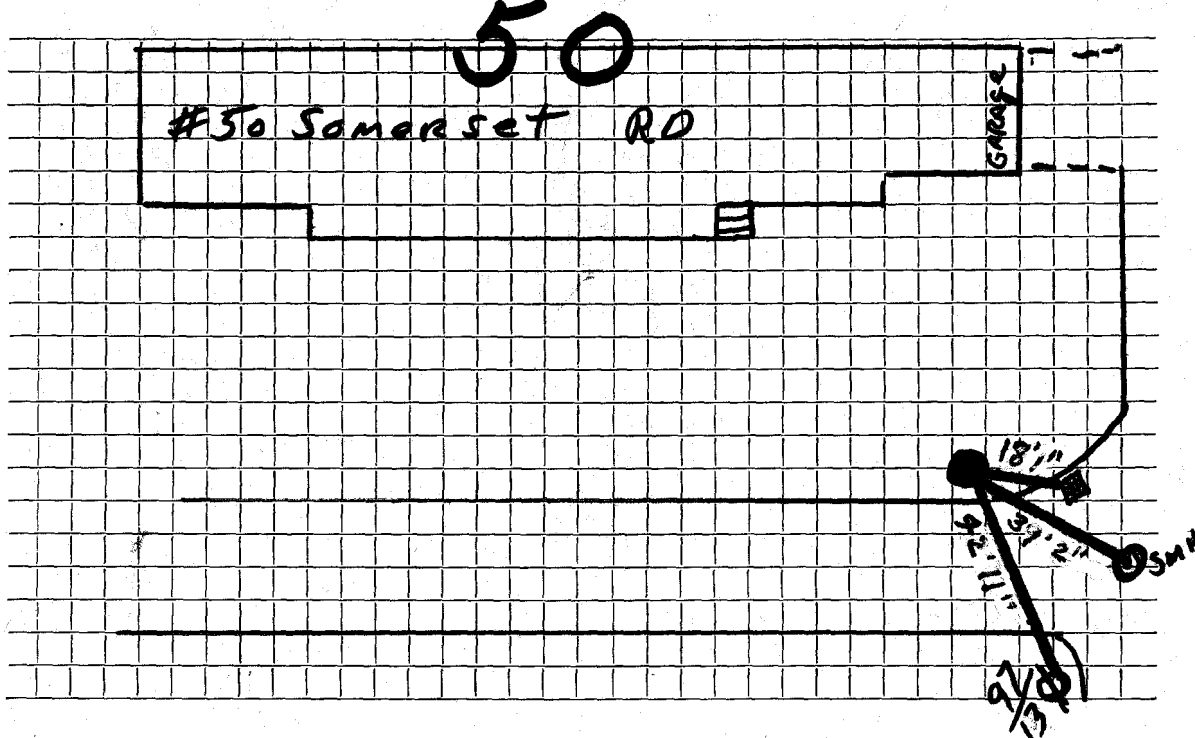

Connection made in Street. Work completed

Remarks:


.....

.....

DATE 6-22-1999

TOWN OF LEXINGTON — BOARD OF PUBLIC WORKS
WATER DIVISION

Sketch of Service Here

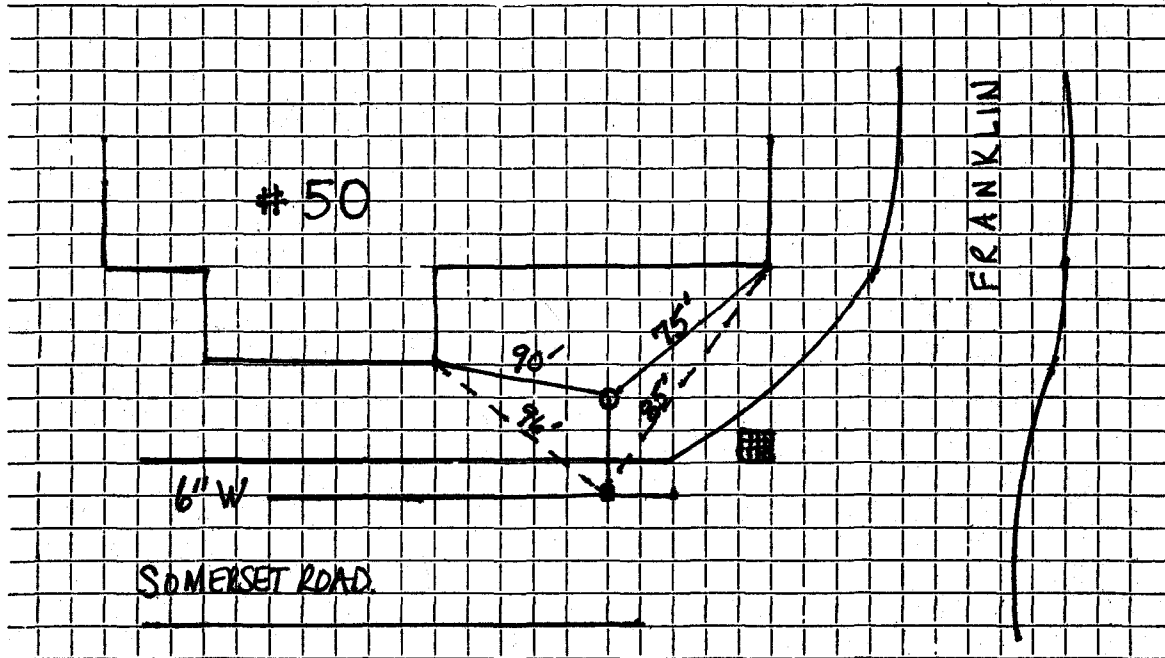

Connection made in STREET OFF 6\" MAIN Street. Work completed

Remarks: CORPORATION & CURB STOP/BOX INSTALLED.