


TOWN OF LEXINGTON — BOARD OF PUBLIC WORKS

WATER DIVISION

Sketch of Service Here

Lot 11

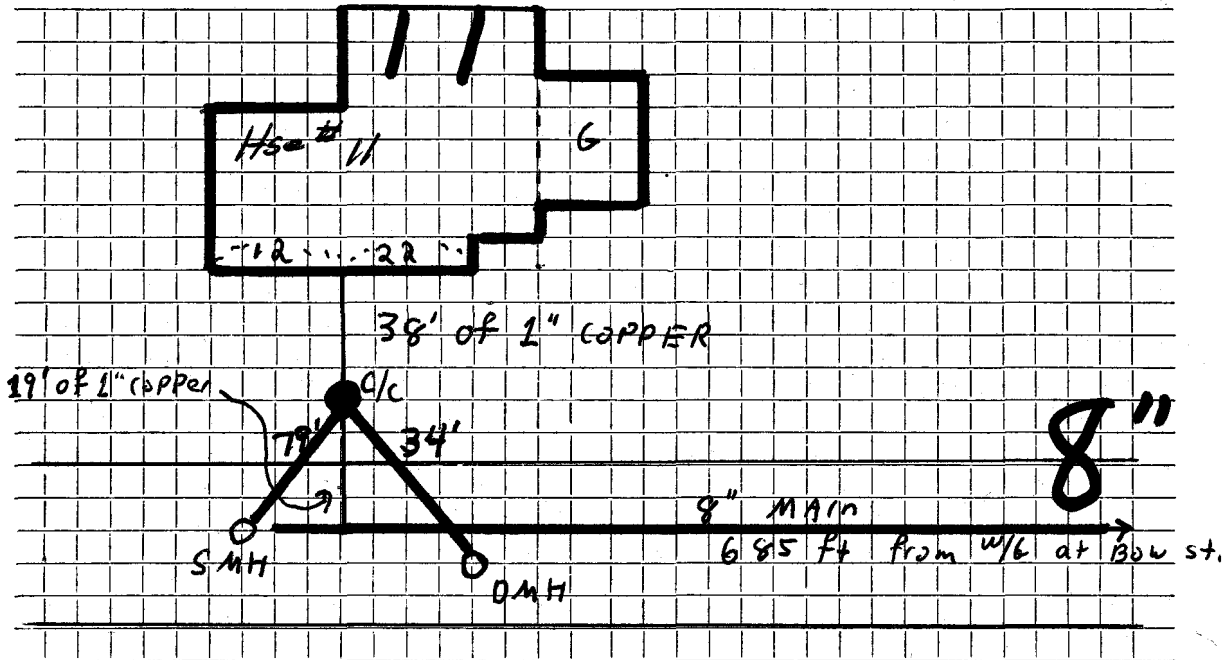

Connection made in Street. Work completed

Remarks:
.....
.....