


DATE _____

TOWN OF LEXINGTON — BOARD OF PUBLIC WORKS

WATER DIVISION

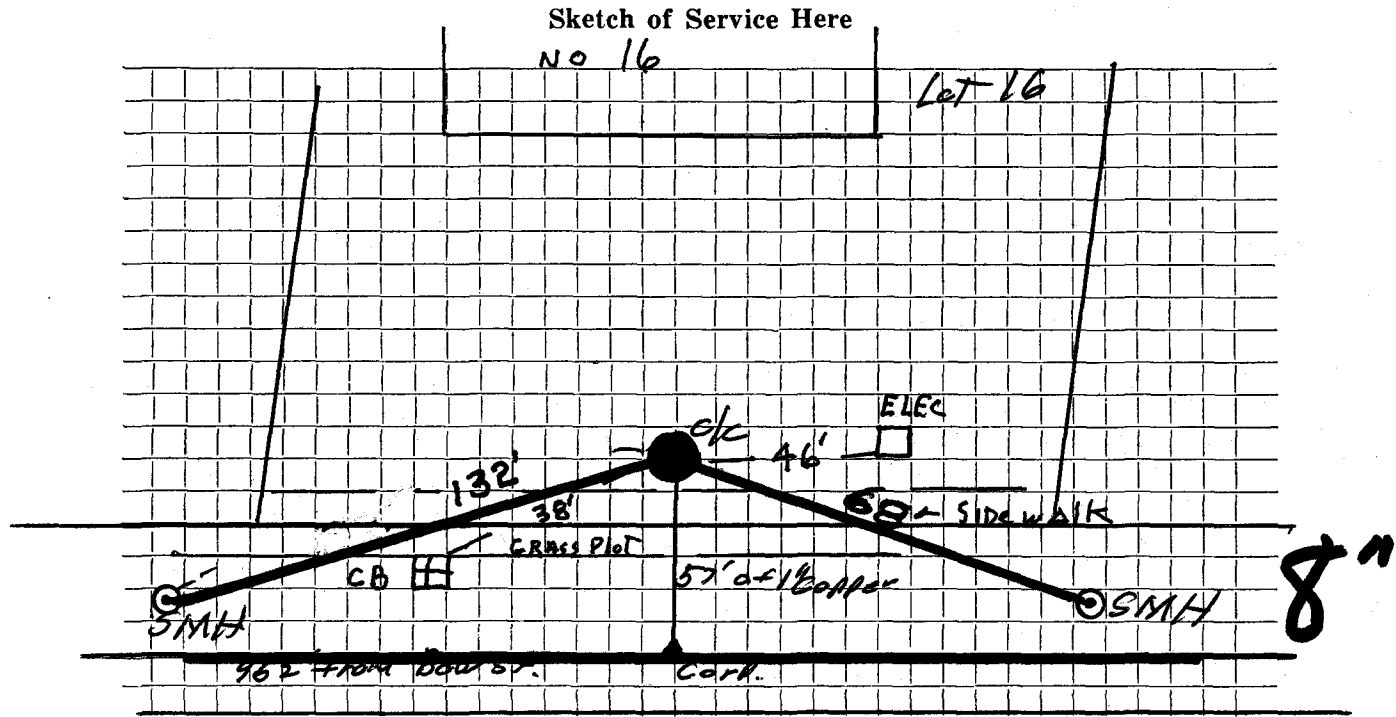

Connection made in SOUTH RINDGE Street. Work completed

Remarks:

.....

.....