

WATER SERVICE RECORD

771

Name Albert Healey

Service No. 46

Address 1 Spencer Street

Location

~~Renewal~~ Renewal ~~W.O. #7995~~ W.O. #7995


Comm 10-28-63

Date	Material	Amount	Total	Date	Material	Amount
6-13-63	Labor	80.38		5-29-63	Deposit	100.00
6-14-63	10% O.H.	8.04	88.42	3-31-64	Paid	50.93
	52' 3/4" Copper tubing @.42		21.84			<u>150.93</u>
	1 3/4" C x 1/2 I.W.H. Stop & Waste		6.17		NON CHARGE	
	3 hrs. Town Shovel @6.50		19.50		Labor	18.58
	2 hrs. Trucking @3.00		6.00		12' 3/4" Copper tubing @.42	5.04
	3 yds. Loam @3.00		<u>9.00</u>		1 3/4" C Adapter	1.62
			150.93		1 3/4" C Curb Cock	6.28
					1 Box & Rod	4.90
					2 bags Rock Wool @1.55	3.10
					1 1/2 Straight tailpiece	.50
					1 1/2 Offset tailpiece	.50
					12 x 3 Patch	12.00
					1 hr. Town Shovel @6.50	6.50
					1 hr. Trucking @3.00	<u>3.00</u>
						62.02
				2-5-66	FREEZE	
					Bill sent 56.93	

DATE _____

TOWN OF LEXINGTON — BOARD OF PUBLIC WORKS
WATER DIVISION

Sketch of Service Here

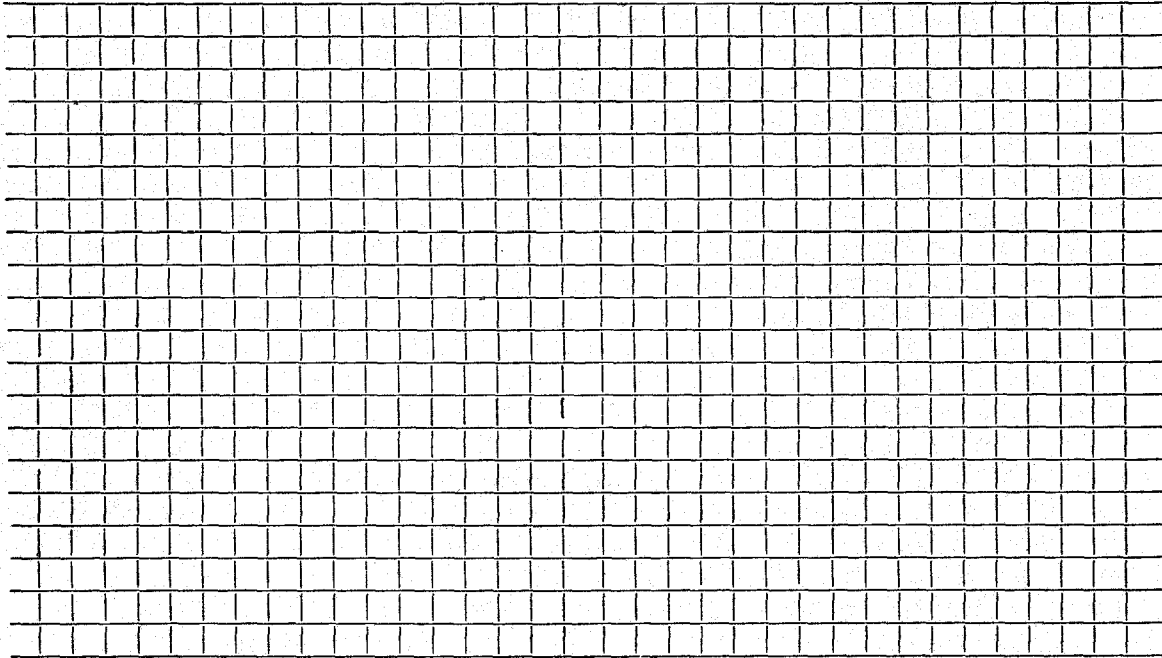

Connection made in Street. Work completed

Remarks: *Original Conn. made May 2, 1937*

.....
.....