

## WATER SERVICE RECORD

Name Howard Fisk

Service No. 57

Address 10 Spencer Street

Location

~~Repair~~ Renewal ~~NEW SERVICE~~

W.O. #4974

MAY 9 1977

Date	Material	Amount	Total	Date	Amount
10/20/76	Labor	61.44		10-15-76	275.00
	10% O.H.	6.14	67.58	5-9-77	149.51
38'	3/4" Copper tubing @.65		24.70		125.79
1	Stop & Waste		14.53		
1	Ground Clamp		.49		
1	Box & Rod		15.40		
	Loam & Seed		3.09		
			125.79		


*Deposit*  
*Refund*

DATE \_\_\_\_\_

TOWN OF LEXINGTON — BOARD OF PUBLIC WORKS

WATER DIVISION

Sketch of Service Here

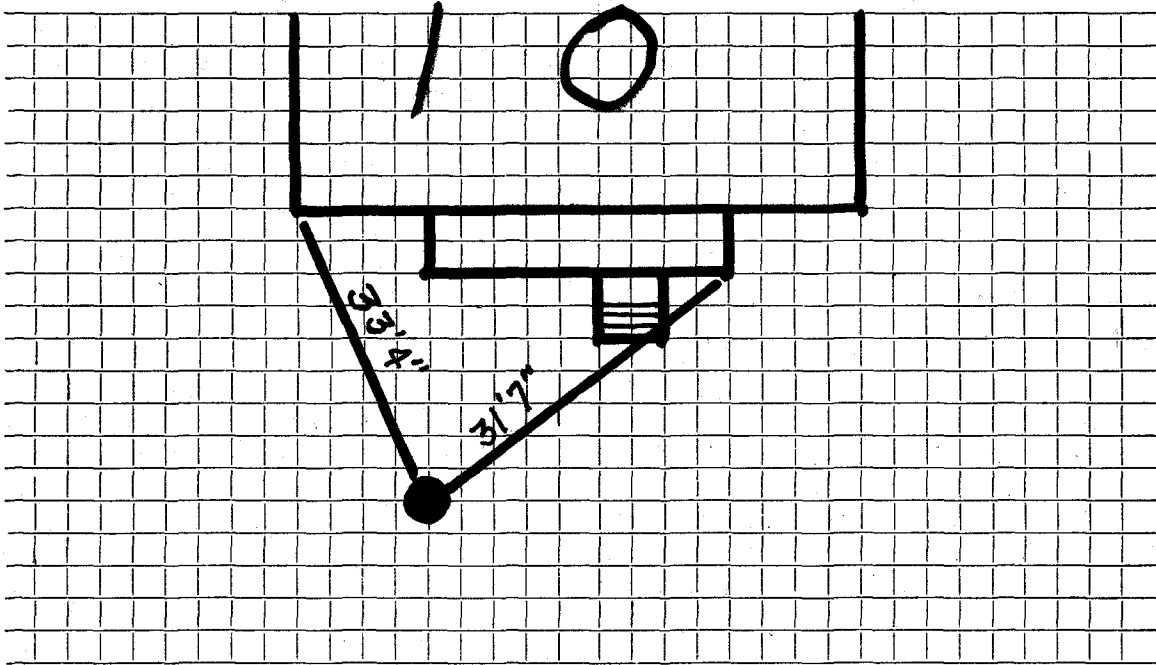

Connection made in ..... Street. Work completed .....

Remarks: Original Service 9-27-1926 .....

.....  
.....