

Name Mrs. Helen P. Cronin

Service No. 2549 56

Address 17 Spencer St.

Location 17 Spencer St.

Kind of Pipe

Size

Size of Main

~~Repair-Rework~~ - New Service

Location

Date	Material	Amount	Total	Date	Amount
Com 31-50	42' 1" Copper Pipe				
9-15-21	1 1" C. to I. Union			Aug. 24 1931 - Cash	31 50
	1 1" Br. S. Nipple	25			
	1 S & W	3 00			
	Trucking	75			
8/25/31	7 Hrs. Labor @ .55	3 85			
	2 " " @ .60	1 20	5 05		
	15% Overhead		76		
COST					
CHARGE	42' @ .75	<u>\$31 50</u>	<u>\$31 50</u>		
	Labor				

Hadley Press, Inc., Lexington

DATE August 14, 1931.

TOWN OF LEXINGTON—BOARD OF PUBLIC WORKS

WATER DIVISION

The undersigned applies for a supply of water at No. 17 Spencer St. and hereby agrees to comply with the rules and regulations as now, or at any future time, established by the Board of Selectmen.

Am't. of Estimate \$ 24.⁰⁰

Owner Helen P. Brown

Am't. Paid \$ _____


Address 10 Spencer St.

Builder _____

Lexington

Sketch of Service Here

#17 SPENCER

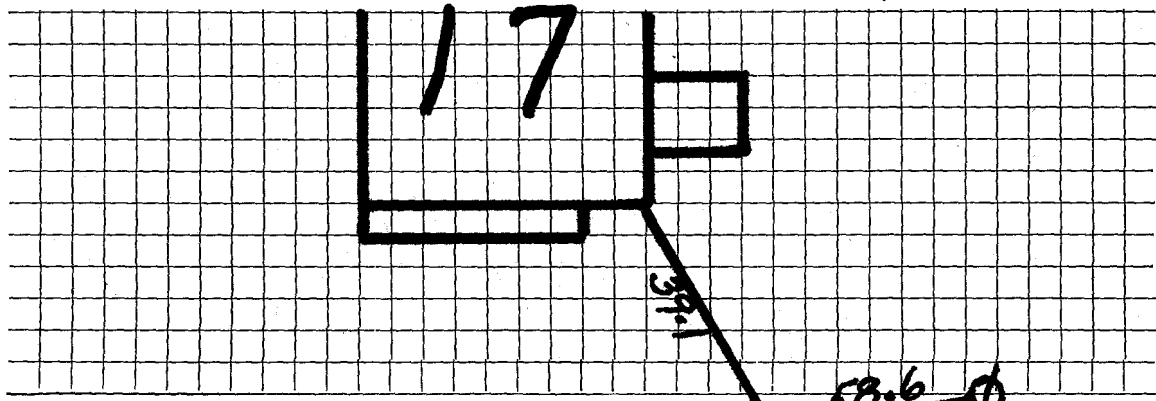

Connection made in _____ Street.

Work completed _____ 19

Remarks: