

Name Saverio Nardelli

Service No. # 2551

Address 731 Main Street, Watertown, Mass.

Location

6313
 6812
 (20-22) Spencer St.

Kind of Pipe

Size

Size of Main

~~Repair - Renewal~~ - New Service

Location

Date
1943

Material

Amount

Total

Date

Amount

May 11
 6/7/43

1 hr.	70	
10% Overhead	75	1 45
42' 1" C.L. Pipe @ 23¢		15
2' 3/4" x 1/2" I.W.H.S. & W. @ 2.35		9 66
1" L.L. Coupling		4 70
1" L.L. Elbow		21
1" L.L. Tee		30
1" Brass close nipple		41
1" C.L. Nipple 3" long		37
2 1" x 3/4" Br. Reducing Coup. @ 45		20
2 3/4" C.L. Close nipples @ .14		90
1 hr. trucking		28
		75
		19 38

Apr 9, 1943 Deposited
 Oct 9, 1943 out etc
 Jan 3, 1943 Rd.

18 00
1 28
10
19 38

Non-chargeable:
 14' 1" C.L. Pipe @ 25¢
 5' 3/4" Copper tubing @ 21¢
 1 3/4" C. corp. cock
 1 3/4" Cx 1" I. Union
 1 1" curb dock
 4 1/2" str. tail pcs. @ 38¢
 1 box & rod
 1 hr. trucking 6/11/43

3 50
1 05
2 25
88
3 52
1 52
1 65
75
15 12
4 70
19 82

Labor

Labor

TOWN OF LEXINGTON—BOARD OF PUBLIC WORKS WATER DIVISION

The undersigned applies for a supply of water at No. 20-22 Spencer St. St. and hereby agrees to comply with the rules and regulations as now, or at any future time, established by the Board of Selectmen.

Am't. of Estimate \$ 18.00

Owner

J. Hardelli


Am't. Paid \$ _____

Address

731 Main St

Builder _____

Watertown Mass.

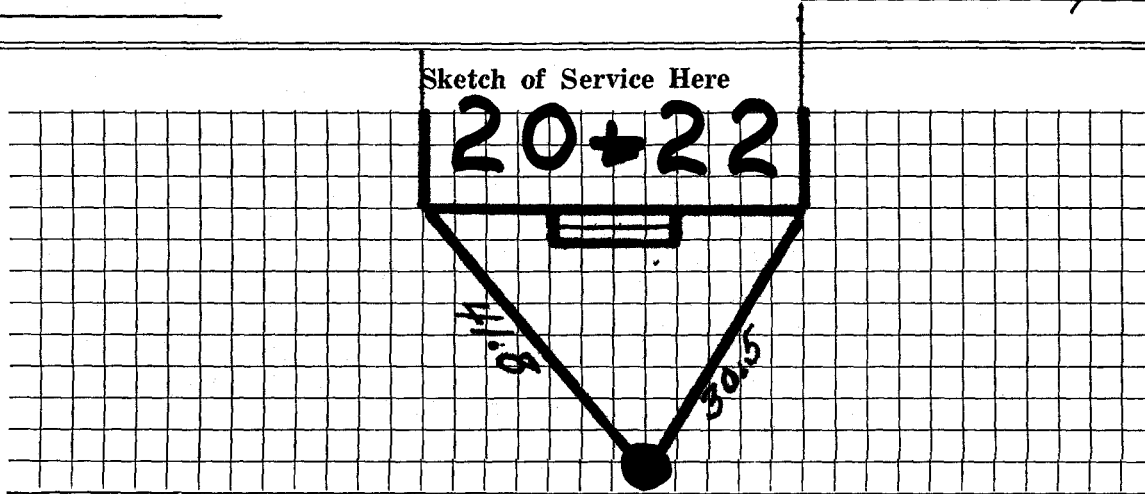

Connection made in _____ Street.

Work completed _____ 19

Remarks: