

WATER SERVICE RECORD

Name

Service No.

Address

23-25 Spencer Street

Location

Repair—Renewal—New Service


Date	Material	Amount	Total	Date	Amount
<i>9/12/88</i>	<i>Copper Renewed</i>				
	<i>28.7 1" Copper</i>				
	<i>1 1"C. Curb Cock</i>				
	<i>1 Box</i>				
				RENEWAL	
				<i>9/15/88 15' 3/4" Copper</i>	
				<i>8 yds. Gravel</i>	
				<i>Corp.</i>	
				<i>Box & Rod</i>	

DATE _____

TOWN OF LEXINGTON — BOARD OF PUBLIC WORKS

WATER DIVISION

Sketch of Service Here

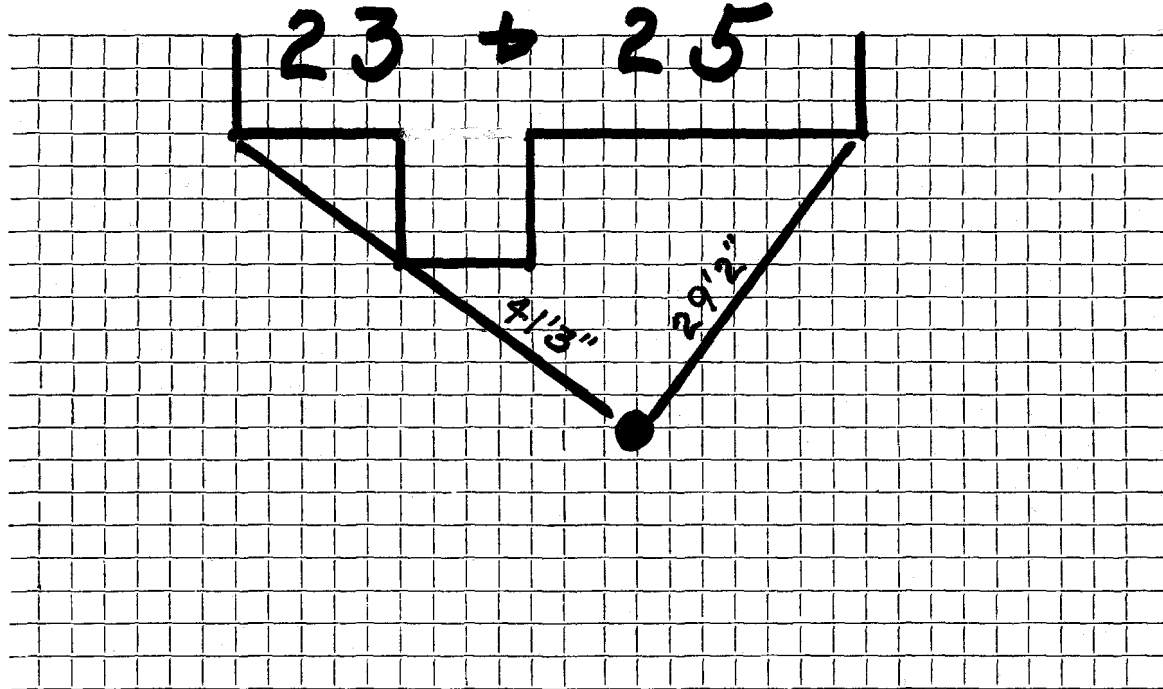

Connection made in Street. Work completed

Remarks:
.....
.....