

Name Saverio Nardelli

Service No.

2553

Address 731 Main Street, Watertown, Mass.

#6309 #6229
↓ ↗

1409

Location

24-26 Spencer St.

Kind of Pipe

Size

Size of Main

~~Repair~~ Renewal - New Service

Location

Date 1943

Material

Amount

Total

Date

Amount

May 11

1 hr. @ 70¢ 70

1 " @ 75¢ 75

10% Overhead

42' 1" C.L. Pipe @ 23¢ 9 66

2 3/4" x 1/2" I.W.H.S. & W. @ 2.35 4 70

1 1" L.L. Coupling 21

1 1" L.L. Elbow 30

1 1" L.L. Tee 41

1 1" Brass. close nipple 37

1 1" C.L. Nipple 3" long 20

2 1" x 3/4" Br. Reducing cup. @ .45 90

2 3/4" C.L. Close Nipple @ .14 28

1 hr. trucking 75

19 38

Apr 9, 1943

Deposited

18 00

Jan 3, 1943

Paid

1 38

19 38

Non-chargeable:

Labor

3 73

14' 1" C.L. Pipe @ 25¢

3 50

5' 3/4" Cop. tub. @ 21¢

1 05

1 3/4" Cop. corp. cock

2 25

1 3/4" Cxl 1" Union

88

1 1" I. Curb cock

3 52

4 1/2" Str. tail pcs. @ 38¢

1 52

1 box & rod

1 65

1 hr. trucking 6/11/43

75

" " 9/27/43

18 85

" " 12/28/43

Labor

Hadley Press, Inc., Lexington

TOWN OF LEXINGTON—BOARD OF PUBLIC WORKS WATER DIVISION

The undersigned applies for a supply of water at No. 24-26 Spencer St. St. and hereby agrees to comply with the rules and regulations as now, or at any future time, established by the Board of Selectmen.

Am't. of Estimate \$ 18.00

Owner

S. Martelli

Am't. Paid \$ _____


Address

731 Main St

Watertown Mass.

Builder _____

Sketch of Service Here

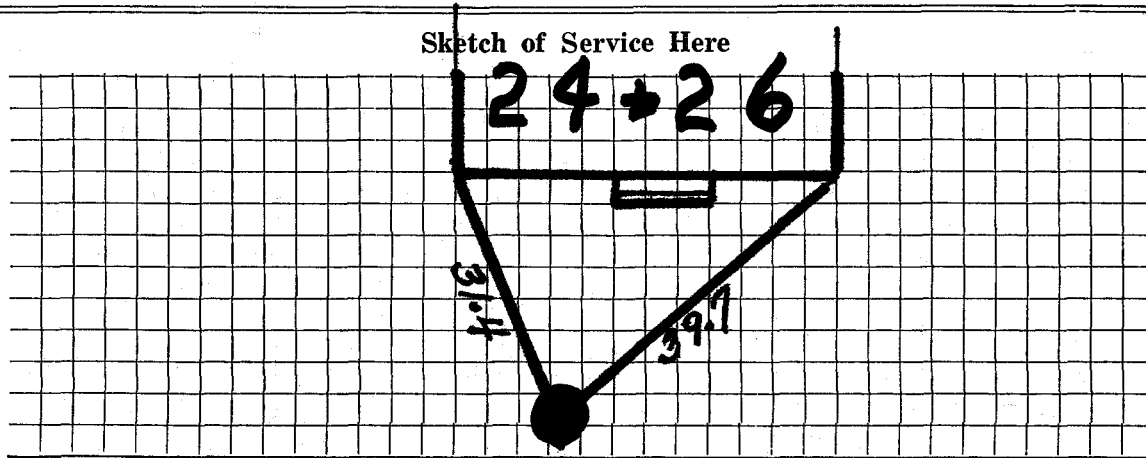

Connection made in _____ Street.

Work completed _____ 19

Remarks: