

WATER SERVICE RECORD

Name John W. Rycroft

Service No. 123

Address 7 Spencer Street

Location

FEB 15 1965  
FEB 15 1965

~~Renewal~~ ~~NEW SERVICE~~ W04 9331


Date	Material	Amount	Total	Date	Amount
11-4-64	Labor	39.25		11-29-64	Deposit 25.00
	10% O.H.	3.93	43.18	2-26-65	Paid 7.50
34'	3/4" Copper tubing @.42		14.28		82.50
1	3/4 x 1/2 Compressor valve		9.29		CURB TO MAIN
1	yd. Loam		3.00	11-4-64	Labor 9.20
1 1/2	hrs. Town Shovel @6.50		9.75	8'	3/4" Copper tubing @.42 3.36
1	hr. Town Trucking		3.00	1	1" Adapter 4.11
			82.50	1	3/4" Curb Cock 8.76
					4 x 3 Patch 4.00
					1 1/2 hrs. Town Shovel @6.50 9.75
				1	hr. Town Truck 3.00
				1	1/2" Tail piece .50
				1	1/2" Offset .50
					43.18
					Bill sent 250

DATE \_\_\_\_\_

TOWN OF LEXINGTON — BOARD OF PUBLIC WORKS

WATER DIVISION

Sketch of Service Here

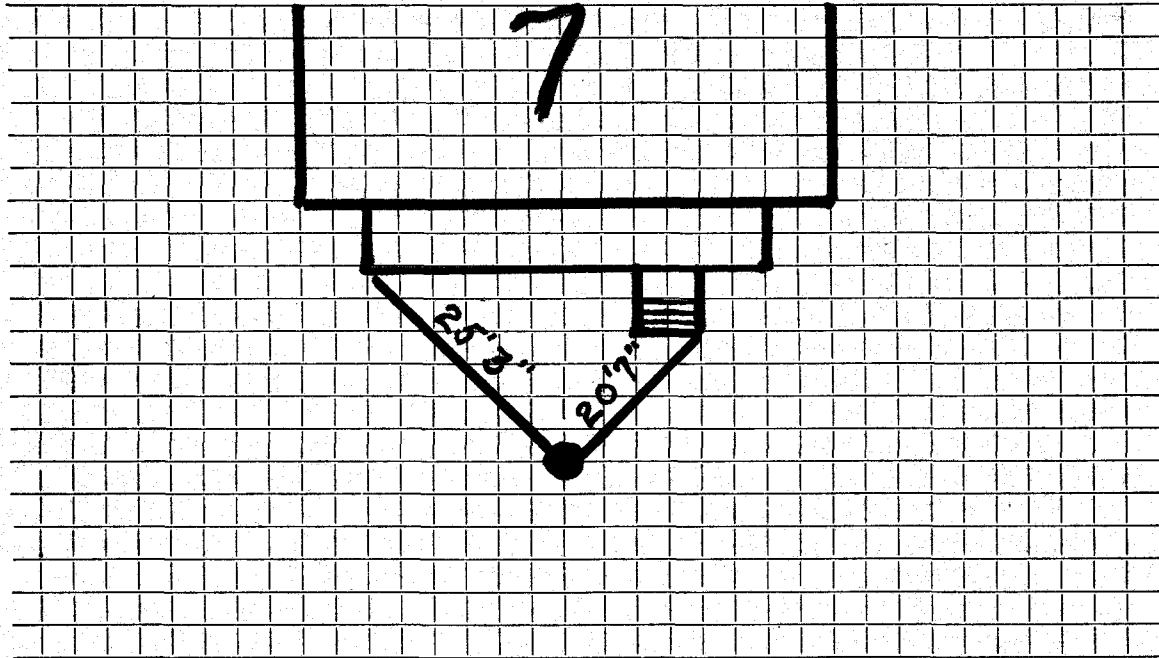

Connection made in ..... Street. Work completed .....

Remarks: *Original Service 5-13-1927* .....

.....  
.....