

WATER SERVICE RECORD

Name

Service No.

Address

8 Spencer Street

Location

~~Repair~~—Renewal—~~New Service~~

W.O.#1823

(outside)


Date	Material	Amount	Total	Date	Amount
3-1-74	Labor	\$144.80			
4-1-74	"	41.60	\$186.40		
	32' 3/4" Copper Pipe @1.05		33.60		
	1 3/4" Union		4.26		
	1/2 Ton Cold Patch		2.06		
	1 3/4" Adapter		3.55		
	1 3/4" Curb Cock		12.45		
	1 Patch 23' x 6'				
			<hr/>		
			\$242.32		
	4 1/2 Hrs. Trucking				
	2 Hrs. Town Shovel				
	1/2 Hr. Loader				
	1 1/2 Hrs. Pick up				
	1/2 Hr. Compressor				
	1 Hr. Roller				

DATE _____

TOWN OF LEXINGTON — BOARD OF PUBLIC WORKS

WATER DIVISION

Sketch of Service Here

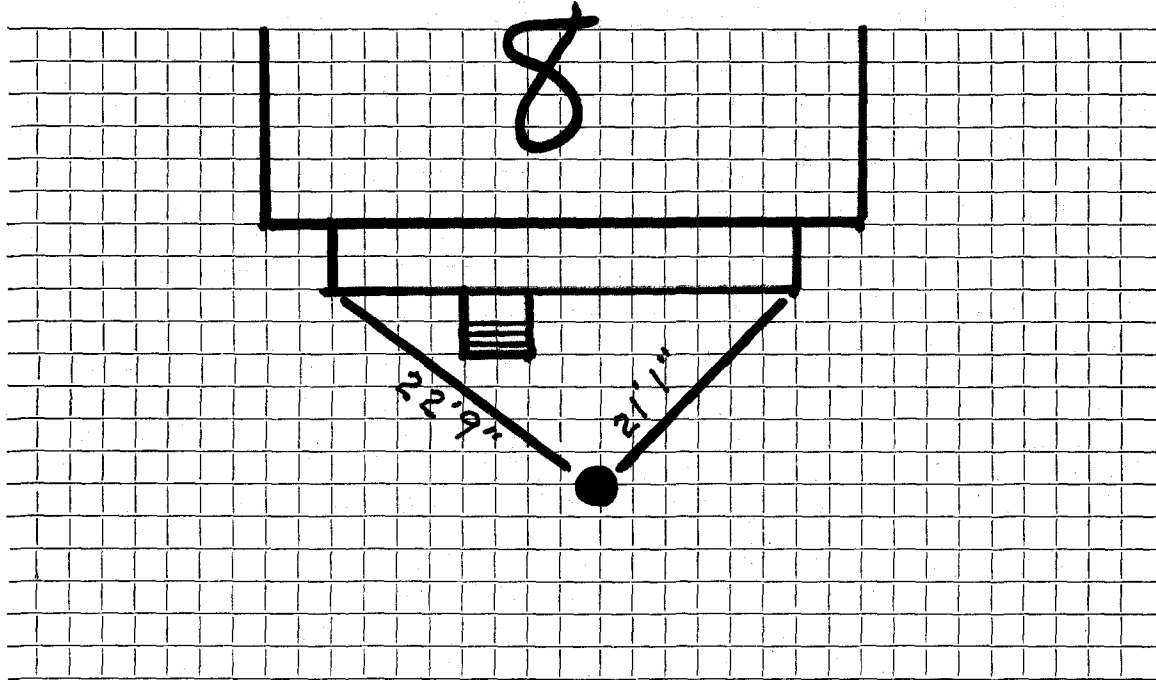

Connection made in Street. Work completed

Remarks: Original Service 8-12-1927

.....
.....