

WATER SERVICE RECORD

Name Anna M. Toomey

Service No. **X 14**

Address 9 Spencer Street

Location


~~Repair~~ ~~Renewal~~ ~~New Service~~ WO #4242

Date	Material	Amount	Total	Date	Amount
4/15/76	labor	71. 20		4/16/76	Deposit 200. 00
	10%OH	7. 12	78. 32	8/16/76	Refund 68. 59
34'	3/4" copper tubing @ .65		22. 10		131. 41
1	3/4X3/4 stop and waste		15. 00		OUTSIDE
1	3/4X1/2 brass bushing		1. 49	4/21/76	Labor 63. 56
1	new ground clamp		. 50	1/2	ton Cold Patch 6. 85
2hr.	shovel @ 6.50		13. 00	2	hrs. Town Shovel @ 6.50 13. 00
1/2 hr.	truck @ 3.00		1. 50	1	hr. Trucking @ 3.00 3. 00
			131. 41		86. 41

DATE _____

TOWN OF LEXINGTON — BOARD OF PUBLIC WORKS
WATER DIVISION

Sketch of Service Here

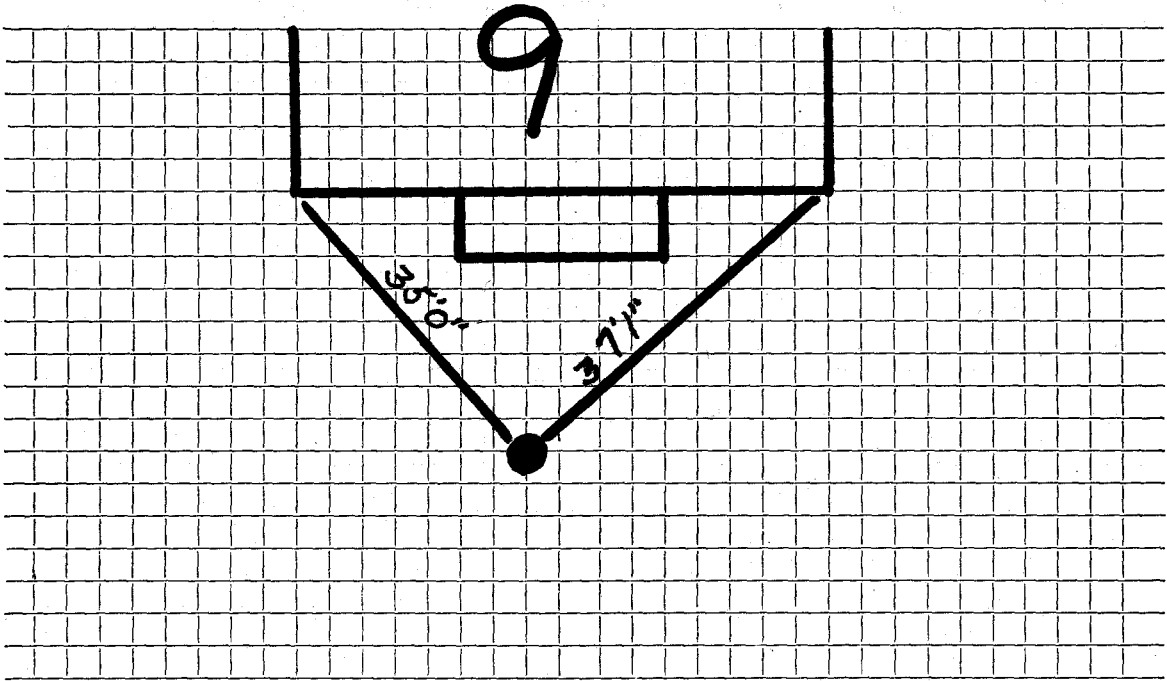

Connection made in Street. Work completed

Remarks:
.....
.....