

WATER SERVICE RECORD

77

Name H. A. Moore

Service No. 82

Address 101 Spring St.

Location Lexington

~~REPLY TO NAME~~ - New Service COM. 6-8-53


Date	Material	Amount	Total	Date	Amount
5/11/53	Labor	6 25		4-30-53	50 -
	10% overhead	63	6 88	6-8-53	67
	40' - 3/4" Copper Tubing @ .34		13 60		NON CHARGE
	1-3/4" C x 1/2 I.W.H. STOP & WASTE		4 00	5/11/53	Labor
	2 Hr. Littlefield Shovel @ 7.50		15 00	6'-3/4" Copper Tubing @ .34	2 04
	1 Hr. Trucking		75	1-3/4" C Corp-cock	4 33
	Patching 3 x 3		3 00	1-3/4" C x 3/4" C. Curb-cock	4 67
			43 23	1-Box & Rod	3 90
				1-1/2 offset tail piece	50
				1-1/2 straight tail piece	50
				1 Hr. Littlefield Shovel	7 50
				1 Hr. Trucking	75
				July 02 14' 1" Copper	30 44
				1" Corp	
				1" Curb	
				1x 7/8 Red	
				buffalo box	

DATE \_\_\_\_\_

TOWN OF LEXINGTON — BOARD OF PUBLIC WORKS

WATER DIVISION

Sketch of Service Here  
SPRING ST

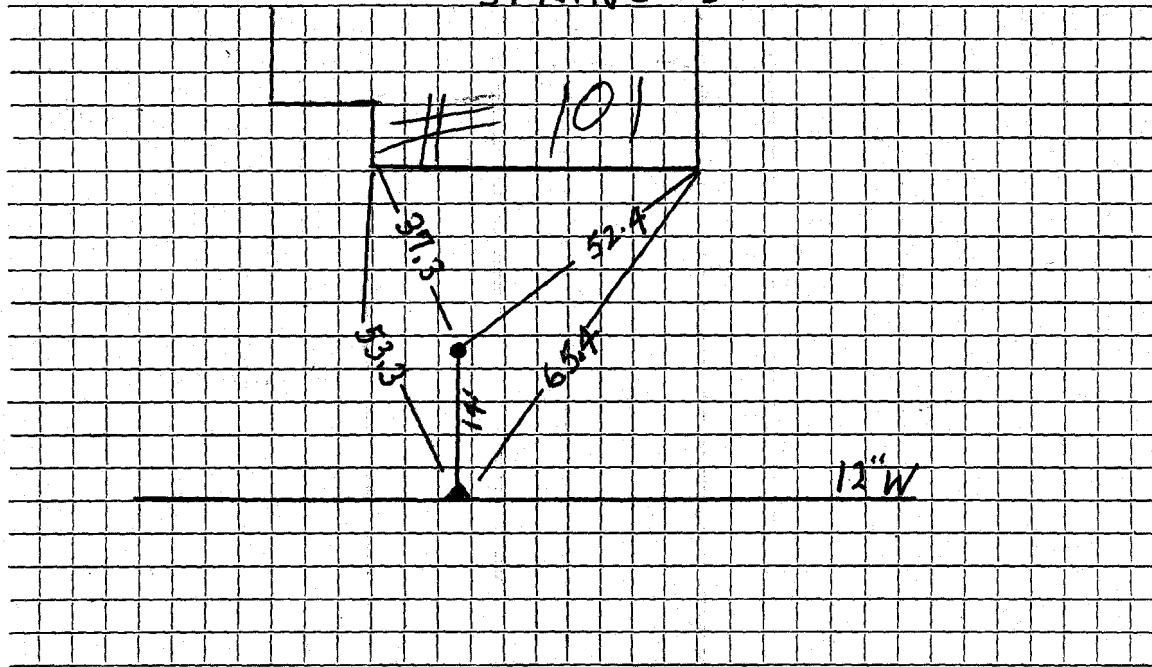

Connection made in ..... Street. Work completed July 2002 Dept. ....

Remarks: .....  
.....  
.....