




TOWN OF LEXINGTON — BOARD OF PUBLIC WORKS

WATER DIVISION

Sketch of Service Here  
SPRING ST

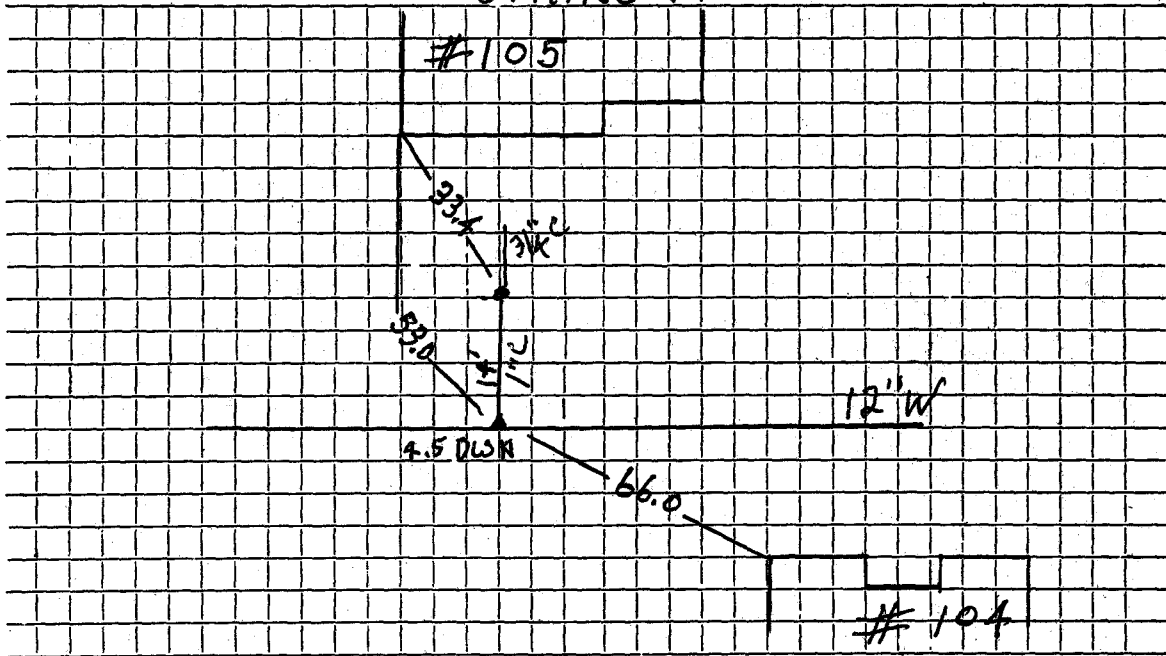

Connection made in ..... Street. Work completed July 2002 .....

Remarks: .....  
.....  
.....