

Name William Fellman

Service No. 90 313/

Address 11 Spring Street

Lexington, Mass.

Location 11 Spring Street

Kind of Pipe

Size

Size of Main ON 12" MAIN

~~Repair-Removed~~—New Service

Com. 5-29-50

Location

Date	Material	Amount	Total	Date	Amount
May 18, '50	Labor	2 45	2 45	May 12 '50	Deposited 35 00
	10% Overhead		25	June 8 '50	Refunded 3 86
	37' - 3/4" Copper Tubing @.23	8 51			No Charge 31 14
	1 - 3/4" C x 1/2" I.W.H. S&W	3 29		May 18, '50	Labor 2 45
	1 - 3/4" C x 3/4" C Union (3pts)	1 39		9' - 3/4" Copper Tubing @.23	2 07
	Littlefield Shovel 1 1/2 hrs. @7.00	10 50		1 - 3/4" C Corp-cock	3 15
	Trucking 1 hr. @.75	75		1 - 3/4" C x 3/4" C Curb-cock	3 85
	Patching 4 x 3		4 00	1 - Box & Rod	3 60
			31 14	1 - 1/2" Offset Tail Piece	38
				1 - 1/2" Straight Tail Piece	38
				Littlefield Shovel 1 hr. @ 7.00	7 00
				Trucking 1 hr. @.75	75
	Labor				23 63

DATE _____

TOWN OF LEXINGTON – BOARD OF PUBLIC WORKS

WATER DIVISION

The undersigned applies for a supply of water at No..... St. and hereby agrees to comply with the rules and regulations as now, or at any future time, established by the Board of Selectmen.

Am't of Estimate \$.....

Owner


Am't Paid \$.....

Address

Builder

.....

Sketch of Service Here

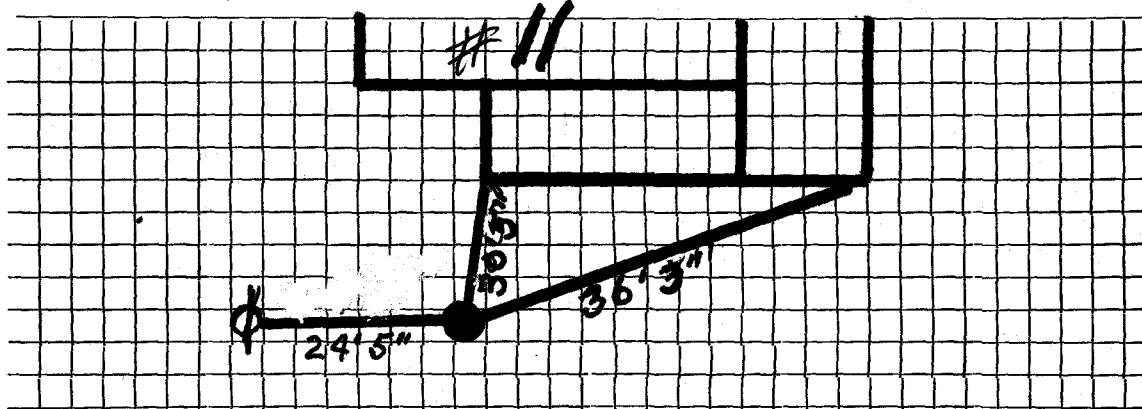

Connection made in Street.

Work completed19

Remarks: