




TOWN OF LEXINGTON — BOARD OF PUBLIC WORKS

WATER DIVISION

Sketch of Service Here  
SPRING ST.

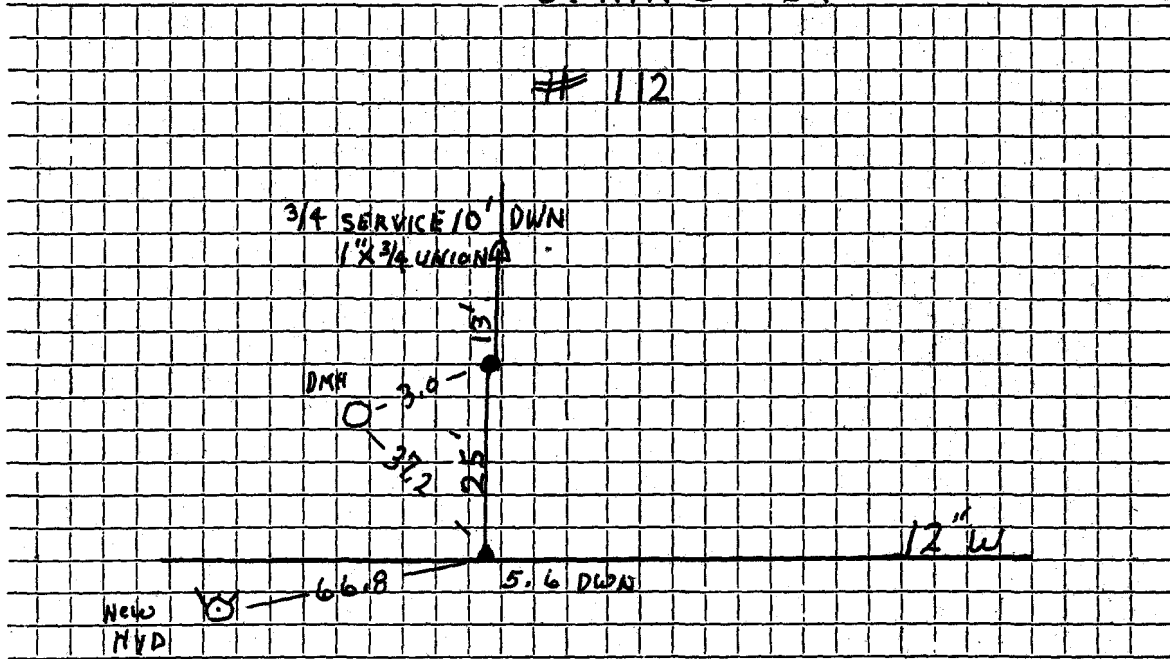

# 112

Connection made in ..... Street. Work completed 2002 .....

Remarks: Found 3/4" service 10' Deep .....